

MICHAEL P. VICTORINO
Mayor

LORI TSUHAKO
Director

LINDA R. MUNSELL
Deputy Director



RECEIVED

RECEIVED

2020 JAN -7 PM 3:13

PM 2:29

OFFICE OF THE MAYOR

OFFICE OF THE
DEPARTMENT OF HOUSING,
& HUMAN CONCERNS
COUNTY OF MAUI
2200 MAIN STREET, SUITE 546
WAILUKU, MAUI, HAWAII 96793
PHONE: (808) 270-7805

January 7, 2020

Honorable Michael P. Victorino
Mayor, County of Maui
200 South High Street
Wailuku, Hawaii 96793

APPROVED FOR TRANSMITTAL

Michael P. Victorino
Mayor

1/8/20
Date

For Transmittal to:

Honorable Tasha Kama, Chair
Affordable Housing Committee
Maui County Council
200 S. High Street
Wailuku, Hawaii 96793

Dear Chair Kama:

**SUBJECT: COUNTY-OWNED PARCEL ON NORTH PAPA AVENUE (KAHULUI)
(AH-8)**

As a follow up to the presentation provided to your committee on December 4, 2019, enclosed is a CD which contains the digital copy of the Structural Condition Analysis and Assessment of Dormitory Facilities of the subject property for your Committee's review.

Thank you for the opportunity to provide this information. Should you have any questions, please feel free to contact me at Ext. 7805.

Sincerely,

Lori Tsuhako

LORI TSUHAKO, LSW, ACSW
Director of Housing and Human Concerns

Enclosure
xc: Housing Division

Structural Condition Analysis and Assessment of Dormitory Facilities

December 17, 2019



Site Located at 820 Ka'ahumanu Avenue, Kahului, Maui 96732 TMK: (2)3-8-07:117

PREPARED FOR
County of Maui - Department of Housing and Human Concerns
2065 Main St. Suite 108
Wailuku, Maui, HI 96793

Analysis Phase for The Department of Housing and Human Concerns (EP No. 19-19)

Structural Condition Analysis and Assessment of Dormitory Facilities

December 17, 2019

PREPARED FOR

County of Maui - Department of Housing and Human Concerns

2065 Main St. Suite 108


Wailuku, Maui, HI 96793

**Analysis Phase for The Department of Housing and Human Concerns (EP No. 19-19)
Summary of Findings for the Existing University of Hawaii Community College Dorm
Campus Buildings and Surrounding Site Located at 820 Ka'ahumanu Avenue, Kahului,
Maui 96732 TMK: (2)3-8-07:117**

Executive Summary:

The purpose of this report is to assess the structural integrity of the existing four structures and viability for repair, and future habitation. The goal is to provide information to the County of Maui so that they can determine the best course of action in terms of renovating or replacing existing four structures located at 820 Ka'ahumanu Avenue. The information and recommendations of the March 28, 2018 Professional Real Estate Inspectors, Property Condition Report was used as reference information in the preparation of this Analysis Report.

Included in this phase are a structural survey of existing conditions for the three dorm buildings plus the existing community building and surrounding site plus cost estimates prepared by a licensed and active General Contractor with commercial construction experience on the Island of Maui.

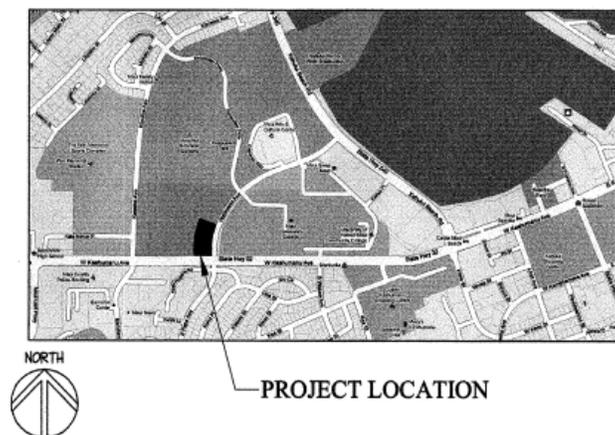

The basis for the analysis of cost and habitability opinion are substantively based on the following information:

General Building Information: The subject property consists of three (3) vacant 2- story apartment type use buildings located in the Kahului area of Maui, Hawaii. There are 12 residential tenant spaces with no tenant(s) presently occupying the property. Each building consisted of four (4) two-bedroom one-bathroom apartment units with a living room and kitchen. There is also a single-story community building with laundry facility. The property has been vacant for approximately 11 years. The structures were built in 1980-81 and the total square footage being discussed is approximately 15,000 square feet. Included in the cost estimate are some site improvements including paving, basic signage and a landscaping allowance. Refer to the PCR section 3.2 for overall site drone footage and exterior building elevation photographs.

1. Field Condition Survey (FCS) by John Ritchey Structural Engineer dated November 7, 2019 - A field condition survey of the existing University of Hawaii Community College Dorm campus buildings, located in Kahului, Maui, to identify and document structural deterioration, damages, or defects that have the potential to adversely affect the existing buildings strength and performance. Removal of drywall or exterior siding specifically selected by the structural engineer to expose every area of structural framing was completed in order to conduct the structure for analysis (Attached as appendix A).

2. Construction Cost Estimate(s) by Castaway Construction dated November 18, 2019 – A line item cost estimate for the complete renovation of the existing structures as well as a cost estimate for the complete replacement of the structures including all electrical and plumbing and fire sprinkler system in addition to the fixtures themselves (Attached as appendix B).

3. Property Condition Report (PCR) conducted dated March 8, 2019 (N.I.C.) - This is a commercial property condition assessment to determine if three (3) former UH dormitories are suitable for housing. This inspection includes invasive and non-invasive inspection methods as well as sampling for asbestos and lead based paint (not attached to this Assessment Report but can be obtained from the County of Maui Department of Human Concerns).

4. Site Visits for visual and physical assessment by project team members began April 9, 2019 and concluded on November 11, 2019 and included 4 or more site visits by each member of the design team.

Scope of Option 1 - Renovation: The renovation option is extensive and thorough. This option includes the removal and replacement of nearly everything except the structural framing and some floor and roof sheathing. The structural components will be brought up to current code(s). All the interior and exterior siding and finishes will be removed and replaced except some second story ceiling finishes. See Appendix 'C' for Mold Remediation requirements. All the cabinetry and base boards and fixtures including plumbing electrical fixtures will be replaced. The renovation option proposes significantly rehabilitated structures using an existing foundation and framing.

Scope of Option 2 – Replacement Down to Slab: Complete removal of the existing structure including all of the fire sprinkler system, plumbing piping, electrical paneling and wiring down to the slab. A building permit would then be obtained and a structure using the existing slab and footprint with the same layout would be built in the same location.

Scope of Option 3 – Complete Replacement: Same as option 2 but with the complete removal of the existing concrete slab.

In summary, the cost for engineering, plan creation, permit processing and construction costs including an estimated schedule to completion are as follows:

| | | | |
|------------|--|------------------|--------------------|
| Option 1 – | Plan preparation and permit processing | 6 Months | \$193,213 |
| | Renovation Cost Estimate | 6 Months | <u>\$3,696,892</u> |
| | TOTAL | 12 Months | \$3,890,105 |
| Option 2 - | Plan preparation and permit processing | 9 Months | \$245,311 |
| | Replacement Down to Slab | 9 Months | <u>\$5,162,654</u> |
| | TOTAL | 18 Months | \$5,407,965 |
| Option 3 - | Plan preparation and permit processing | 9 Months | \$386,302 |
| | Complete Replacement | 12 Months | <u>\$6,203,895</u> |
| | TOTAL | 31 Months | \$6,740,197 |

Conclusion:

The structural analysis along with a cost estimate including any remediation that may be necessary was enough to establish professional opinions of Architect, Structural Engineer and Contractor that all buildings can be made habitable under Option 1 Renovation. Options 2 and 3 are also viable options that achieve the result of providing 12 quality housing units for transitional homeless housing.

Included along with this executive summary are:

Appendix A - Field Condition Survey (FCS) by John Ritchey Structural Engineer dated 11/7/2019

Appendix B - Construction Cost Estimate(s) by Castaway Construction 11/18/19

Appendix C - EPA Mold Remediation in Schools and Commercial Buildings September 2008

APPENDIX 'A'



John Ritchey Structural Engineer, LLC.

Structural Engineering and Consulting

308 Pulihi Street

Kahului, Maui, HI 96732

jr@jrse.engineer

808.727.2839

www.jrse.engineer

M19011

November 7, 2019

County of Maui - Department of Housing and Human Concerns

2065 Main St. Suite 108

Wailuku, Maui, HI 96793

**Re: Emergency Proclamation to Provide Homeless House – Analysis Phase (EP No. 19-19)
Summary of Structural Field Condition Survey for the Existing University of Hawaii Community
College Dorm Campus Buildings and Appurtenances**

A field condition survey, performed by John Ritchey Structural Engineer, LLC (JRSE), of the existing University of Hawaii Community College Dorm campus buildings, located in Kahului, Maui, to identify and document structural deterioration, damages, or defects that have the potential to adversely affect the existing buildings strength and performance. Existing dorm buildings A, B, and C were assessed on August 28 thru August 30, 2019. The recreational center was assessed on November 6, 2019.

The following structural deterioration observed in Building's A, B, and C include the following:

1. At various locations, termite damage is present on beams, posts, sill plates, sole plates, studs, and sheathing.
2. At various locations, concrete spalls, with exposed corroded reinforcing steel, anchor rods, or both, is present on the exterior face of the concrete foundation wall.
3. At various locations, dry damage is present on sole plates and sheathing.
4. Typically, moisture damage is present on the floor sheathing in bathrooms, and it is present on the second-floor landing of building 2.

The locations of damages, where observed, are presented in Exhibit F – Drawings. Photographs of the types of damages are referenced on the plans and depicted in Exhibits A thru C for each respective building.

The following construction defects observed in Building's A, B, and C include the following:

1. At various locations, Door and window openings missing full-height, continuous, king studs on each side of opening.
2. Single sill plates are installed at wide window openings.
3. At various locations, window openings are missing sill plates.
4. At various locations, window openings are missing headers.
5. Typically, stairwell windows are supported on stacked, spaced, wood blocks.
6. Stud wall framing is missing below the intermediate stair landing.
7. At various locations, vegetation is present against the building façade, and it is present within the building at the exterior face of the first story sole plate.
8. At various locations, exterior finish grade is less than 6 inches below the exterior sheathing.
9. Blocking between trusses supported on beams is not installed.
10. Second story sole plate nailing was not observed in-place.
11. Gable end-wall bracing is not installed.
12. First and second story partition walls support weight of trusses and floor joists.
13. Second floor exterior wall blocking is not installed where floor joists are parallel to wall.
14. Truss web bracing is not installed.
15. At various locations, stud wall sole plate anchors are installed greater than 32" apart or missing.



The locations of construction defects, where observed, are presented in Exhibit F – Drawings. Photographs of the types of construction defects are referenced on the plans and depicted in Exhibits A thru C for each respective building.

The following structural deterioration observed in the Recreational Center Building include the following:

1. The top northwest corner of the concrete pier at Gridline '5-D' is broken off, spalled.
2. At Gridline '5-D', the top of the wood post is damaged by termites. The end of the beam, along Gridline '5', at this location is also damaged by termites.
3. At various locations, exterior sheathing is damaged or missing.
4. Minor dry rot is present at the base of the wood post at Gridline '1-D'.
5. A small region of roof sheathing is moderately damaged adjacent to Gridline's 'B-4'. A depression can be seen from the exterior.

The locations of damages, were observed, are presented in Exhibit F – Drawings. Photographs of the types of damages are referenced on the plans and depicted in Exhibit D.

The following construction defects observed in the Recreational Center Building include the following:

1. Truss web bracing is not installed.
2. At various locations, stud wall sole plate anchors are installed greater than 32" apart or missing.
3. Gable end-wall framing is not installed.
4. At various locations, let-in braces are not installed per the original structural drawings.
5. At various locations, Door and window openings missing full-height, continuous, king studs on each side of opening.
6. At various locations, windows are supported on spaced blocks, shims. It is unknown if the windows are attached at these locations.

The locations of construction defects, where observed, are presented in Exhibit F – Drawings. Photographs of the types of construction defects are referenced on the plans and depicted in Exhibit D.

The following other conditions were observed:

1. Live termites are present in buildings B and C.
2. Termite mud tubes were observed at several locations on wood framing members.
3. The masonry barbecue pit has cracked masonry units, missing masonry units, and a warped concrete slab.
4. The storage building's roof is severely damaged. Multiple trusses are missing members. One trusses' bottom chord is broken. The wood framed stem wall atop the masonry wall is partially collapsed.

Photographs of the types of damages are depicted in Exhibit E for each respective site appurtenance.



In the opinion of JRSE, the buildings condition ratings are listed in Table 1. Condition rating is based on the original construction's conformance with the original structural drawings and standards of construction at the time, and the degree of damage/deterioration present at the time of this condition survey.

Table 1 – Building Condition Rating

| Building/Appurtenance | Condition | Commentary |
|----------------------------------|-----------|---|
| Building A | Fair | There is deterioration and defects severe enough to be addressed in the near term. Primarily the deterioration in the form of large concrete spalls and single and missing sole plates at large window openings. |
| Building B | Poor | There is severe damage and defects severe enough to limit occupancy to authorized personnel and are to be addressed immediately. Primarily the deterioration in the forms of severe, extensive, dry rot damage to sole plates in B-201 and B-202; severe termite damage to roof beams in B-202; severe termite damage to first story posts, supporting the roof beams in B-202, located in B-201; and severe termite damage to the header in B-201 at Gridline '1'. |
| Building C | Fair | There is deterioration and defects severe enough to be addressed in the near term. Primarily the severe dry rot damage to sole plates. |
| Recreation Center | Good | There is minor deterioration limited to the lanai posts at Gridline '5-D' and '1-D'. |
| Trash Enclosure/Storage Building | Poor | There is severe damage and defects severe enough to limit occupancy to authorized personnel and addressed immediately. Primarily the deterioration in the form of a partially collapsed stem wall supporting the roof and several roof trusses with missing member components or damaged. One truss has a broken bottom chord. |
| Barbeque Pit | Poor | There is severe damage and defects. Primarily the cracked masonry walls and damaged concrete slab. |

In the opinion of JRSE, the existing buildings can be repaired and retrofitted to bring them back into service and allow residential occupancy. JRSE recommends the following to repair and retrofit the existing buildings:

- Remove and replace dry rot and termite damaged wood members.
- Treat building for termites.
- Remove and replace dry rot and termite damaged sheathing.
- Install missing members.
- Install additional sill plate at wide openings.
- Install blocking at second floor at exterior walls where floor joist framing is parallel to the wall.
- Repair damaged concrete and treat corroded reinforcing steel elements – rebars and anchor rods.
- Tighten all loose nuts.
- Install the minimum number of fasteners as per the existing structural drawings for all sole plates.
- Treat corrosion of steel wall braces.



- Install truss web bracing.
- Install gable end wall bracing.

Prior to any demolition and during construction, the existing structural shall be shored as required. The contractor shall be responsible for all shoring. The contractor shall provide temporary erection bracing and shoring for all structural members as required for structural stability of the structure during all phases of construction.

In addition to fixing the in-situ damages and original construction defects, the building shall be retrofitted to conform to the County of Maui's current building code; the *2006 International Building Code*, *ASCE 7-05 Minimum Design Loads for Buildings and Other Structures* and *Ordinance 3928*.

- Continuous lateral force resisting system to resist wind forces and seismic inertial forces: Structural analysis and design of the existing lateral force resisting system. Evaluation of existing roof and floor diaphragm, shear walls, and affiliated components and connections. The existing structure might require additional shear walls, metal ties, metal straps, metal hold downs, gable end wall bracing, and increases in floor and wall sheathing nailing.
- Seismic evaluation of non-structural components: Seismic evaluation of non-structural components – sprinkler systems, water heaters, air handling units, etc. Analysis and design of supporting framing members, connections, and bracing.
- Continuous wind uplift force resisting system to resist wind uplift pressures: Structural analysis and design of wind uplift force resisting system. Evaluation of existing building components and connections. Evaluation of the existing structure will require the installation of metal connections, straps, hold downs, and anchor rods.
- Evaluation of existing gravity system shall be undertaken to assess the in-situ framing. JRSE does not anticipate any retrofits required for the gravity system except retrofit of beam to beam connections supported on wood cleats.
- Evaluation and retrofit of the existing framing to conform to current standards of constructions. This results in the addition of blocking, support of non-load bearing walls, minimum requirements for sole plate anchorage, notches and holes, corner tie straps, etc.

The completed inspection was of a visual nature only. No testing, measurements, or dismantling of any portion of the building was undertaken and not within the scope of this assessment. Inspections were made on a random basis with no attempt to review or inspect every element or portion of the building and its systems. The intent of this review was to determine areas of visually obvious deterioration in need of repair, and to assess, in a general way, the overall quality and sufficiency of the building structural system only. The contents of this report, JRSE findings and recommendations do not in any way represent a warranty for or certification of the building's various systems.

The review of the building systems did not include any assessment or confirmation of the accuracy or completeness of the original design. It was assumed that the design and construction of building structural system was in general compliance the requirements of the applicable codes and standards in-place at the time of construction.

Inspection for the presence or absence of materials such as mold, asbestos, PCBs or other noxious, hazardous or toxic materials in the building or on the site was not within the scope of JRSE's mandate. Should concerns exist regarding the presence of the materials, specialized consultants should be retained to perform the appropriate testing and inspections.

Should you have any questions, comments, or require additional information, please do not hesitate to contact us.



Cordially,

JOHN RITCHEY STRUCTURAL ENGINEER, LLC.

John Ritchey, PE
President

Attachments

Exhibit A thru E – Photos

Exhibit F – Drawings

Exhibit G – Structural Engineering Fee for Repair/Retrofit

Exhibit H – Structural Engineering Fee for Replacement



EXHIBIT A – BUILDING A PHOTOS

OBSERVED IN-SITU DAMAGE & CONSTRUCTION DEFECTS

A1D: FIRST STORY DAMAGE



PA1D.1: Typically, metal wall braces exhibit minor to moderate rust.



PA1D.2: At various locations, exterior foundation wall face is spalled with exposed corroded reinforcing steel.



EXHIBIT A – BUILDING A PHOTOS



PA1D.3: Concrete spall with exposed corroded sole plate anchor rod.



PA1D.4: Sole plate dry rot.



PA1D.5: Cracked exterior slab at rusting drain-pipe.



EXHIBIT A – BUILDING A PHOTOS

A1CD: FIRST STORY CONSTRUCTION DEFECTS



PA1CD.1: At various locations, sole plate anchor rods nuts are loose.



At various locations, interior wall sole plate anchor rods are missing or installed with spacing greater than 32" on-center.



PA1CD.2: Daylight observed at base of wall.

EXHIBIT A – BUILDING A PHOTOS



PA1CD.3: At various locations, vegetation is present at interior face of first story walls.



PA1CD.4: Building paper missing at interior face of wall sheathing.



PA1CD.5: Stud wall framing not in-place beneath stair landing at exterior wall.

EXHIBIT A – BUILDING A PHOTOS



PA1CD.6: At various locations, openings missing king jamb post(s).



PA1CD.7: At various locations, wide wall opening with single sill plate.



PA1CD.8: Discontinuous stud.



EXHIBIT A – BUILDING A PHOTOS



PA1CD.9: At various locations, openings missing sill plate.

A2D: SECOND STORY DAMAGE



PA2D.1: Moisture stains present on plywood sheathing adjacent to rusty pipe.



EXHIBIT A – BUILDING A PHOTOS

A2CD: SECOND STORY CONSTRUCTION DEFECTS



PA2CD.1: Wide opening single sill plate.



PA2CD.2: Missing opening sill plate. Window supported on studs.



PA2CD.3: Missing wall blocking.



EXHIBIT A – BUILDING A PHOTOS

ARD: ROOF DAMAGE



PARD.1: Beam overhang dry rot.



EXHIBIT B – BUILDING B PHOTOS

OBSERVED IN-SITU DAMAGE & CONSTRUCTION DEFECTS

B1D: FIRST STORY DAMAGE



PB1D.1: Sole plate dry rot.



PB1D.2: Siding dry rot.



PB1D.3: Post termite damage.

EXHIBIT B – BUILDING B PHOTOS



PB1D.4: Stud termite damage. Sill plate termite damage.



PB1D.5: Beam termite damage.



PB1D.6: Rusting steel wall braces.

EXHIBIT B – BUILDING B PHOTOS

B1CD: FIRST STORY CONSTRUCTION DEFECTS



PB1CD.1: Missing opening king post.



PB1CD.2: Wide opening with single sill plate.

EXHIBIT B – BUILDING B PHOTOS



PB1CD.3: Missing opening sill plate.



PB1CD.4: Vegetation against building façade.



PB1CD.5: Exposed bottom of footing.



EXHIBIT B – BUILDING B PHOTOS

B2D: SECOND STORY DAMAGE



PB2D.1: Floor sheathing dry rot.



PB2D.2: Sole plate dry rot.



PB2D.3: Sheathing dry rot.

EXHIBIT B – BUILDING B PHOTOS



PB2D.4: Stud termite damage.

B2CD: SECOND STORY CONSTRUCTION DEFECTS



PB2CD.1: Missing wall blocking.

EXHIBIT B – BUILDING B PHOTOS



PB2CD.2: Missing blocking

BRD: ROOF DAMAGE



PBRD.1: Beam termite damage.



EXHIBIT C – BUILDING C PHOTOS

OBSERVED IN-SITU DAMAGE & CONSTRUCTION DEFECTS

C1D: FIRST STORY DAMAGE



PC1D.1: Concrete spall with exposed corroded reinforcing steel.



PC1D.2: Split sole plate.



PC1D.3: Siding dry rot.

EXHIBIT C – BUILDING C PHOTOS



PC1D.4: Post termite damage.



PC1D.5: Stud termite damage.



PC1D.6: Termite mud tracks on member surfaces.



EXHIBIT C – BUILDING C PHOTOS

C1CD: FIRST STORY CONSTRUCTION DEFECTS



PC1CD.1: Missing opening king post.



PC1CD.2: Wide opening with single sill plate.



PC1CD.3: At various locations, vegetation against building façade.



EXHIBIT C – BUILDING C PHOTOS

C2D: SECOND STORY DAMAGE



PC2D.1: Beam termite damage.



PC2D.2: Moisture damage to floor sheathing adjacent to rusting pipe.

C2CD: SECOND STORY CONSTRUCTION DEFECTS



PC2CD. 1: Missing opening king post.

EXHIBIT C – BUILDING C PHOTOS



PC2CD.2: Wide opening with single sill plate.



PC2CD.3: Missing opening sill plate.



PC2CD.4: Missing opening header.



EXHIBIT C – BUILDING C PHOTOS



PC2CD.5: Missing wall blocking.

CRD: ROOF DAMAGE



PCRD.1: Beam overhang dry rot.



EXHIBIT D – RECREATION CENTER PHOTOS

OBSERVED IN-SITU DAMAGE & CONSTRUCTION DEFECTS

RC1D: FIRST STORY DAMAGE



RC1D.1: Minor concrete spall at the northwest corner of the concrete pier at Gridlines '5-D'.



RC1D.2: Post at Gridlines 'D-1'; minor dry rot present at southeast corner of post base



RC1D.3: Damaged siding at southwest corner of women's restroom.

EXHIBIT D – RECREATION CENTER PHOTOS



RC1D.4: Sole plate dry rot at heater room.

RC1CD: FIRST STORY CONSTRUCTION DEFECTS



RC1CD.1: At various locations, sole plate anchor rods are installed at more than 32 inches on-center or missing.



RC1CD.2: At various locations, windows are supported on spaced blocks.

EXHIBIT D – RECREATION CENTER PHOTOS



RC1CD.3: At various locations, let-in braces are not installed as shown per the original structural drawings.



RC1CD.4: At various locations, headers are installed as continuous members spanning over multiple openings. The original drawings specify an individual member over each opening.



RCICD.5: Odd framing above office window.

EXHIBIT D – RECREATION CENTER PHOTOS



RCICD.6: At various locations, scab (aka king post) is not installed against the jamb post as specified per the original structural drawings.



RC1CD.7: Typically, recreational room north, east, and west openings are missing double wood plate above the opening.

EXHIBIT D – RECREATION CENTER PHOTOS

RCRD: ROOF DAMAGE



RCRD.1: Moderate termite damage present at beam to column connection at Gridlines '5-D'.



RCRD.2: Region of damaged plywood sheathing.





EXHIBIT D – RECREATION CENTER PHOTOS

RCRCD: ROOF CONSTRUCTION DEFECTS



RCRCD.1: Web bracing missing.



RCRCD.2: Gable end wall missing stud wall framing.



EXHIBIT E – MISC STRUCTURES PHOTOS

TRASH ENCLOSURE/STORAGE BUILDING



PTESB1: Overview of Trash Enclosure/Storage Building looking north.



PTESB2: Overview of Trash Enclosure/Storage Building looking easterly.



PTESB3: Rusting trash enclosure door.

EXHIBIT E – MISC STRUCTURES PHOTOS



PTESB4: Damaged storage building roof.



PTESB5: Interior view of storage building.



PTESB6: Collapsed storage building south wood framed stem wall. Damaged truss bottom chord.

EXHIBIT E – MISC STRUCTURES PHOTOS



PTESB7: Damaged trusses. Missing truss framing.

BARBEQUE PIT




PBP1: Damaged concrete masonry unit barbecue pit. Missing blocks, cracked masonry, and warped concrete fire slab.



PBP2: Damaged concrete masonry unit barbecue pit. Missing blocks, cracked masonry, and warped concrete fire slab.



EXHIBIT F – DRAWINGS

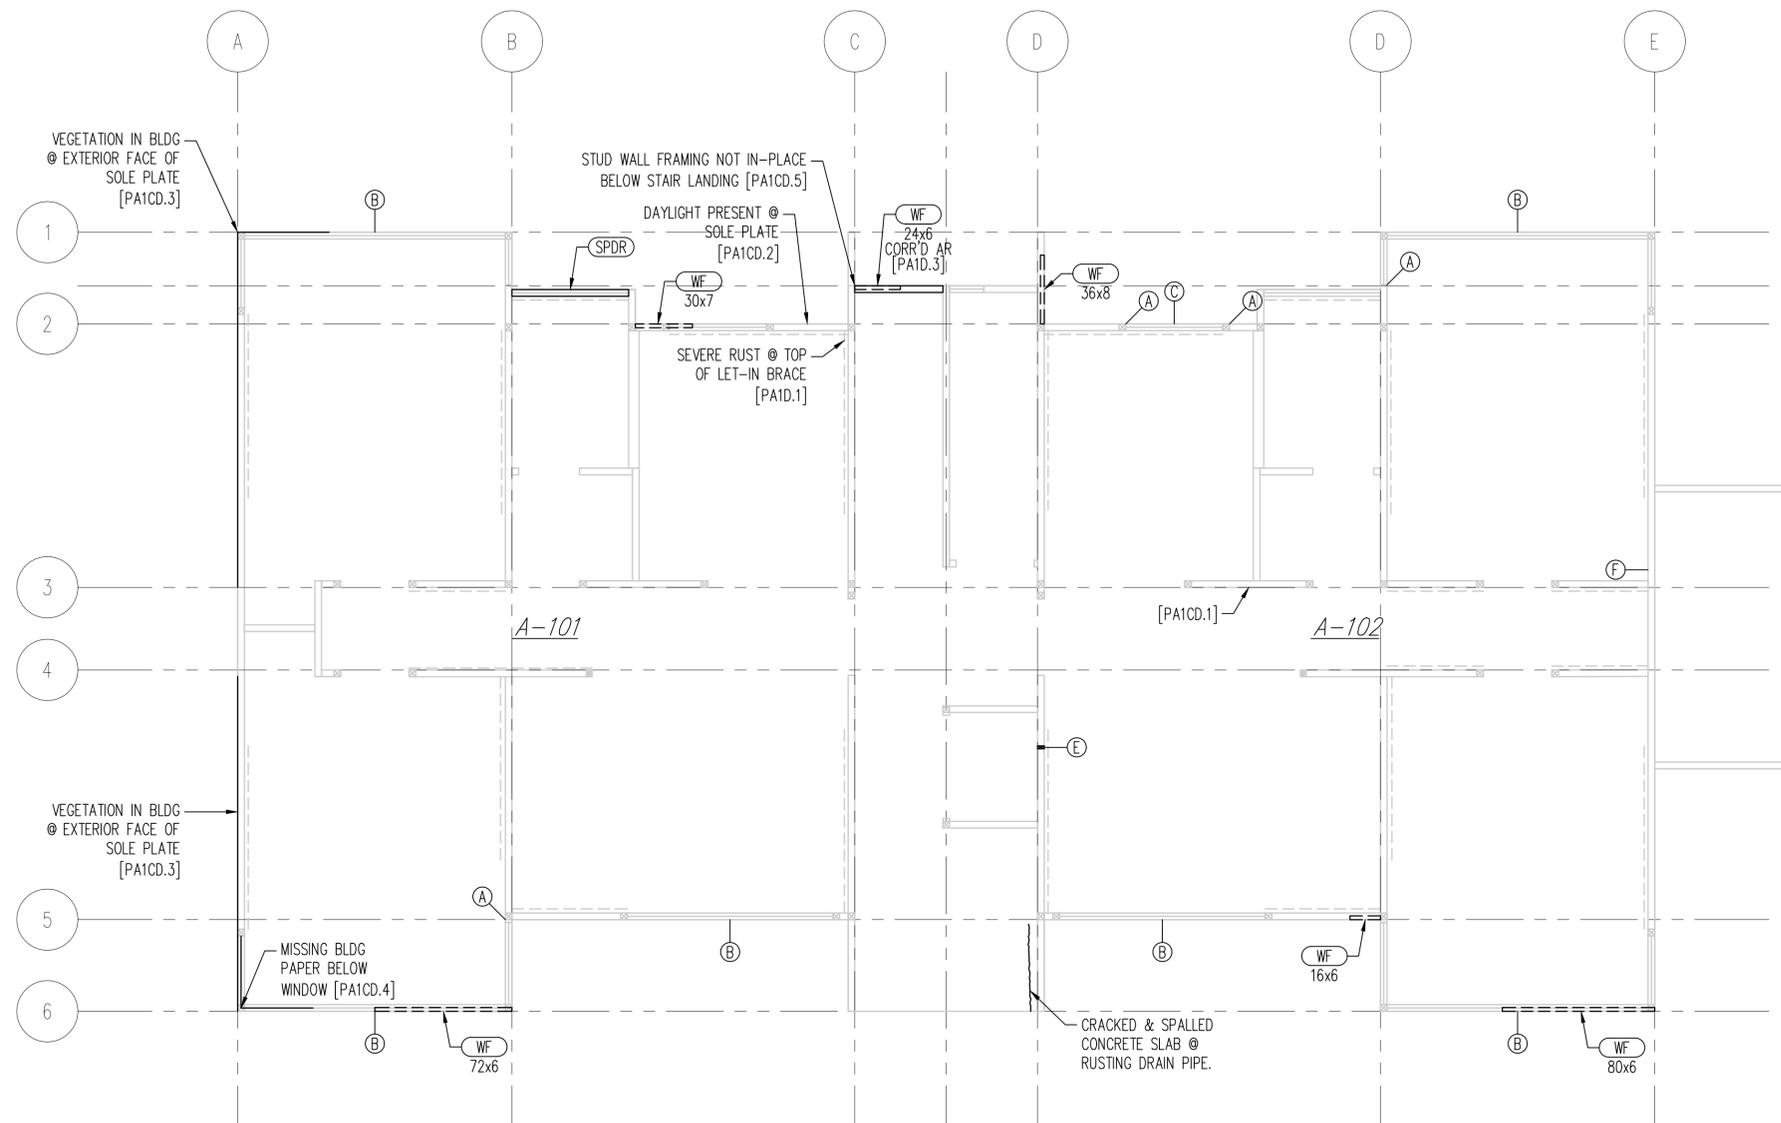

1 EXIST BUILDING A FOUNDATION PLAN
S-1 1/4" = 1'-0"

- LEGEND:**
- WF (LENGTH x HEIGHT) DENOTES CONCRETE SPALL OR DELAMINATION AT WALL FACE WITH EXPOSED CORRODED REBAR [PA1D.2]
 - SPDR SOLE PLATE DRY ROT [PA1D.4]
 - SDR SIDING DRY ROT
 - PTD POST TERMITE DAMAGE
 - STD STUD TERMITE DAMAGE
 - BTD BEAM TERMITE DAMAGE
 - P[#]## PHOTO; SEE EXHIBIT A & PHOTO ID


GENERAL DAMAGE NOTES:
1. TYPICALLY, STEEL LET-IN BRACES EXHIBIT MODERATE CORROSION. [PAD.1]

GENERAL CONSTRUCTION DEFECTS NOTES:
1. AT VARIOUS LOCATIONS, SOLE PLATE ANCHOR ROD NUTS ARE LOOSE. [PACD.1]
2. TYPICALLY, INTERIOR PARTITION WALL SOLE PLATE ANCHOR RODS ARE MISSING OR INSTALLED @ GREATER THAN 32" OC.
3. AT VARIOUS LOCATIONS, SIDING IS LOOSE AT BOTTOM EDGE. [PA1CD.2]

CONSTRUCTION DEFECTS LEGEND:

- A. MISSING OPENING KING POST. [PA1CD.6]
- B. OPENING SINGLE SILL PLATE. [PA1CD.7]
- C. MISSING OPENING SILL PLATE [PA1CD.9]
- D. MISSING OPENING HEADER.
- E. DISCONTINUOUS STUD. [PA1CD.8]
- F. DISCONTINUOUS TOP PLATE.

GENERAL PLAN NOTES:
FOR EXISTING BUILDING INFORMATION NOT SHOWN, SEE GENERAL NOTES, REFERENCED DRAWINGS.

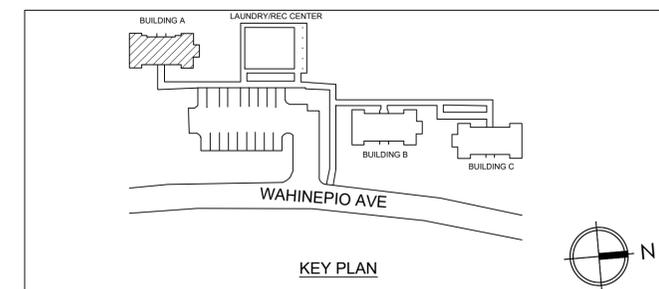

| REVISION NO. | DESCRIPTION | DATE | APPROVED |
|--------------|-------------|------|----------|
| | | | |



THIS WORK WAS PREPARED BY ME OR UNDER MY SUPERVISION AND CONSTRUCTION OF THIS PROJECT WILL BE UNDER MY OBSERVATION


J.R.
SIGNATURE

COUNTY OF MAUI
DEPARTMENT OF HOUSING & HUMAN CONCERNS
EMERGENCY PROCLAMATION TO PROVIDE HOMELESS HOUSING - ANALYSIS PHASE
EP NO. 19-19
MAUI COUNTY, HI 96732
TMK: (2)3-8-007:11

BUILDING A PLANS

DRAWING NO.
S-1

308 PULUHI ST.
KAHULUI, MAUI, HAWAII
96732
P: 808.727.2839
E: JR@JRSE.COM
JOHN RITCHIEY, STRUCTURAL ENGINEER LLC
E: JR@JRSE.COM

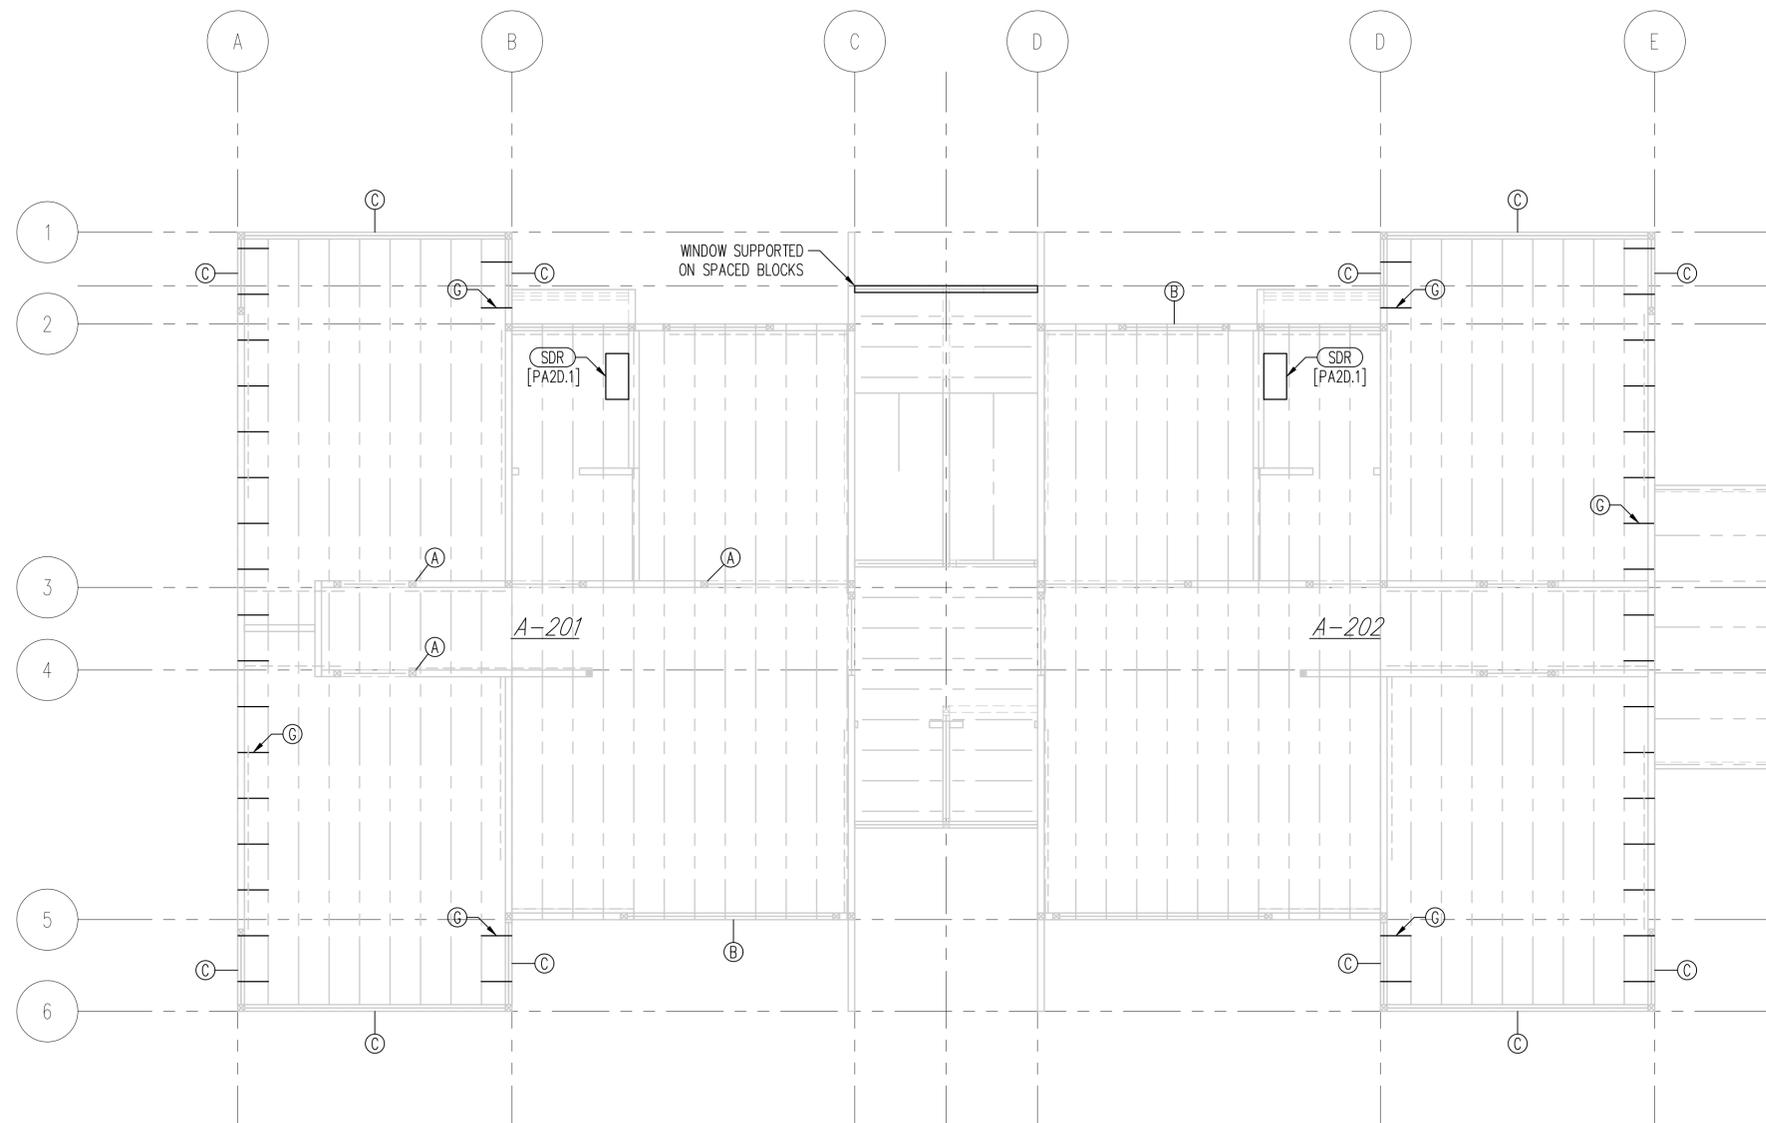

1 EXIST BUILDING A FLOOR FRAMING PLAN
 S-2 1/4" = 1'-0"

LEGEND:


- (SPDR) SOLE PLATE DRY ROT
- (SDR) SIDING DRY ROT
- (PTD) POST TERMITE DAMAGE
- (STD) STUD TERMITE DAMAGE
- (BTD) BEAM TERMITE DAMAGE
- P[#I##] PHOTO; SEE EXHIBIT A & PHOTO ID

GENERAL DAMAGE NOTES:

1. TYPICALLY, SOLE PLATE NAILING WAS NOT OBSERVED IN-PLACE.

(A) CONSTRUCTION DEFECTS LEGEND:

- A. MISSING OPENING KING POST.
- B. OPENING SINGLE SILL PLATE. [PA2CD.1]
- C. MISSING OPENING SILL PLATE. [PACD.2]
- D. MISSING OPENING HEADER.
- E. DISCONTINUOUS STUD.
- F. DISCONTINUOUS TOP PLATE.
- G. MISSING BLOCKING. [PACD.3]

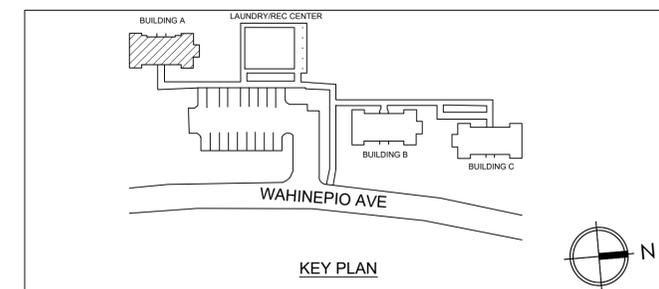

| REVISION NO. | DESCRIPTION | DATE | APPROVED |
|--------------|-------------|------|----------|
| | | | |



THIS WORK WAS PREPARED BY ME OR UNDER MY SUPERVISION AND CONSTRUCTION OF THIS PROJECT WILL BE UNDER MY OBSERVATION

John K. Ritchey
 SIGNATURE

COUNTY OF MAUI
 DEPARTMENT OF HOUSING & HUMAN CONCERNS
 EMERGENCY PROCLAMATION TO PROVIDE HOMELESS HOUSING - ANALYSIS PHASE
 EP NO. 19-19
 MAUI COUNTY, HI 96732
 TMK: (2)3-8-007:11

BUILDING A PLANS

DRAWING NO.
S-2

4/30/2020
 EXP. DATE OF THE LICENSE

308 PULUHI ST.
 KAHULUI, MAUI, HAWAII
 96732
 P: 808.727.2839
 E: JR@JRSE.ENGINEER


JOHN RITCHIEY, STRUCTURAL ENGINEER LLC
 JOHN RITCHIEY, ENGINEER

LEGEND:


- (BDR) BEAM DRY ROT [PARD.1]
- (BTD) BEAM TERMITE DAMAGE
- P[#][#] PHOTO; SEE EXHIBIT A & PHOTO ID

GENERAL CONSTRUCTION DEFECTS NOTES:

1. TYPICALLY, TRUSS WEB ARE UN-BRACED.
2. AT VARIOUS LOCATIONS, DAYLIGHT IS OBSERVED AT RIDGE.
3. GABLE END WALL IS UN-BRACED.

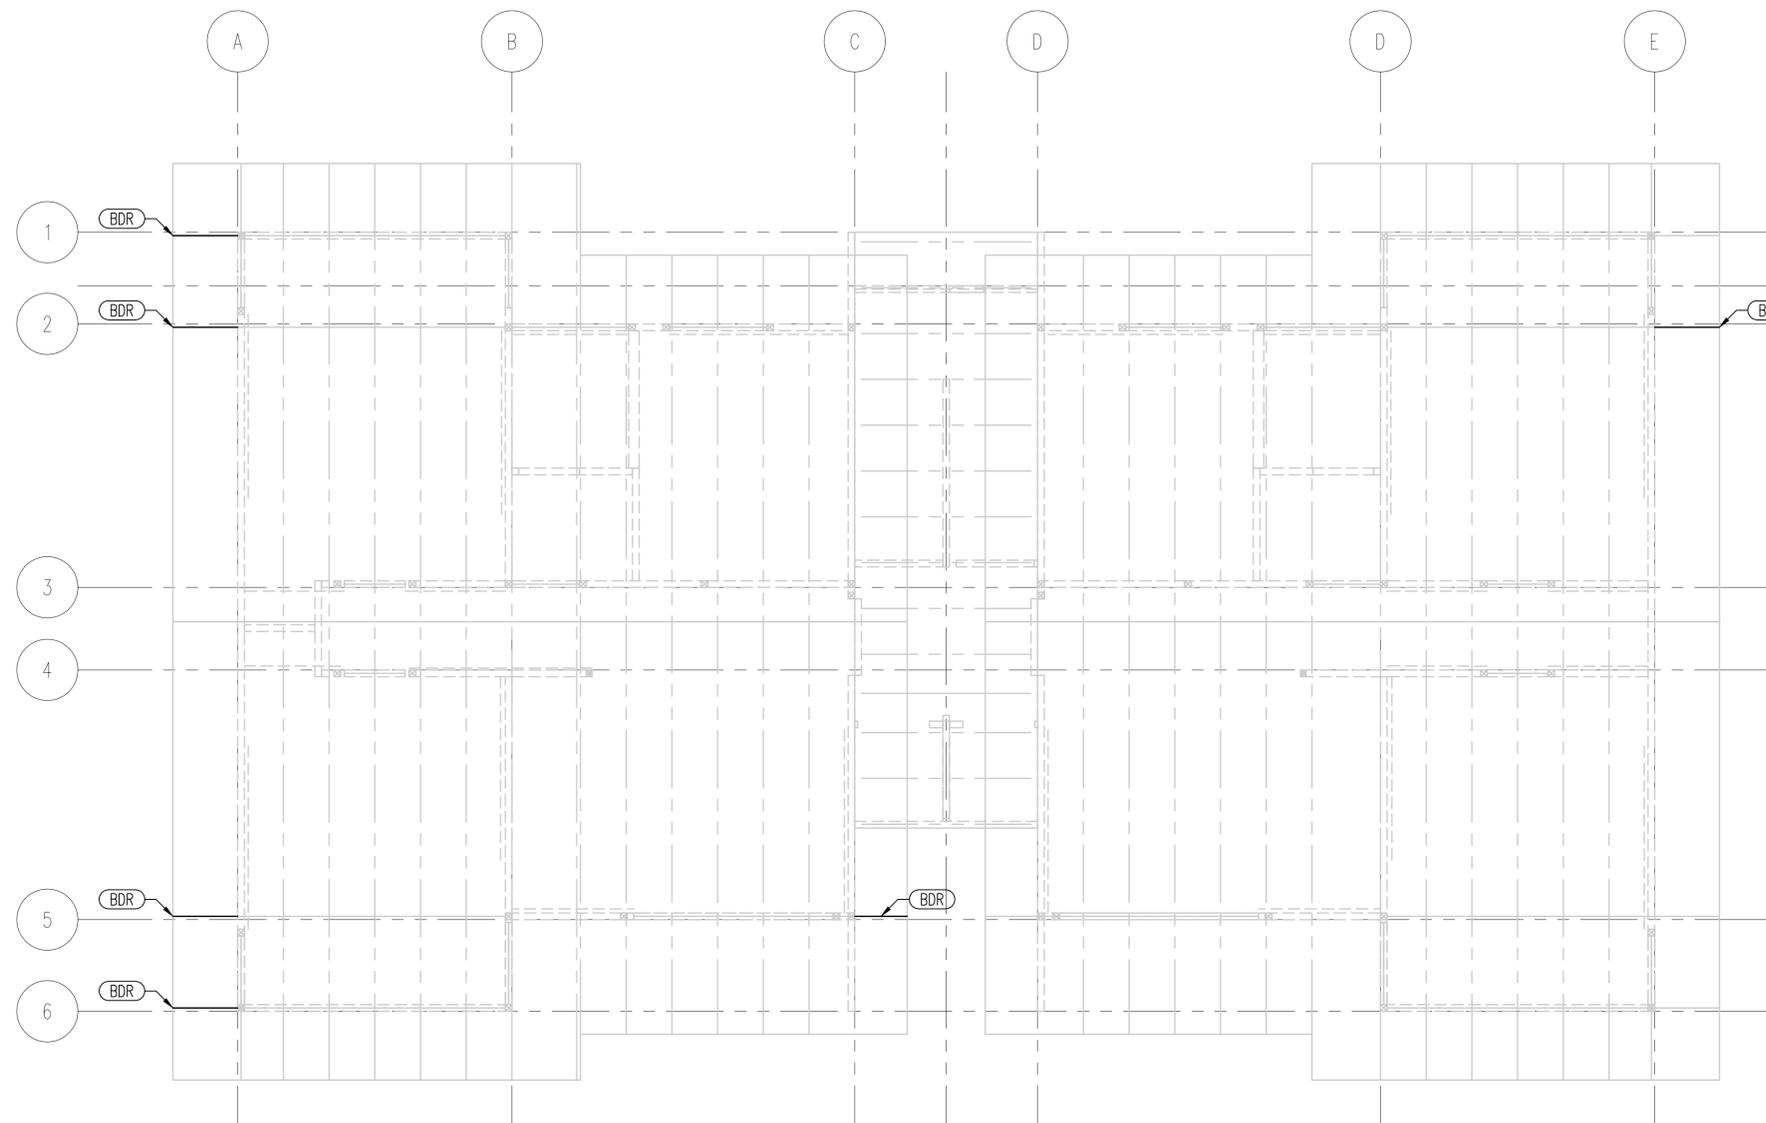

1 EXIST BUILDING A ROOF FRAMING PLAN
S-3 1/4" = 1'-0"

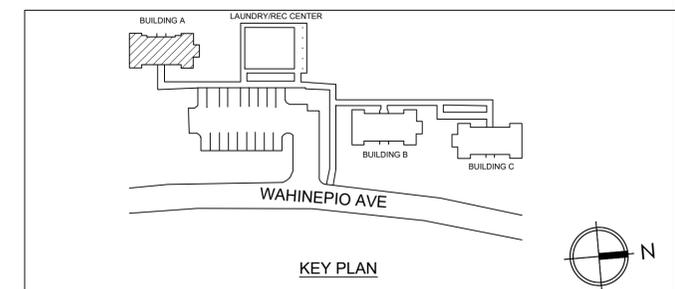

| REVISION NO. | DESCRIPTION | DATE | APPROVED |
|--------------|-------------|------|----------|
| | | | |



THIS WORK WAS PREPARED BY ME OR UNDER MY SUPERVISION AND CONSTRUCTION OF THIS PROJECT WILL BE UNDER MY OBSERVATION

J. Ritchey
SIGNATURE


COUNTY OF MAUI
DEPARTMENT OF HOUSING & HUMAN CONCERNS
EMERGENCY PROCLAMATION TO PROVIDE HOMELESS HOUSING - ANALYSIS PHASE
EP NO. 19-19
MAUI COUNTY, HI 96732
TMK: (2)3-8-007:11

BUILDING A PLANS

DRAWING NO.
S-3

308 PULUH ST.
KAHULUI, MAUI, HAWAII
96732
P: 808.727.2839
E: JR@JRSE.ENGINEER

JOHN RITCHIEY, STRUCTURAL ENGINEER LLC
EXP. DATE OF THE LICENSE
4/30/2020

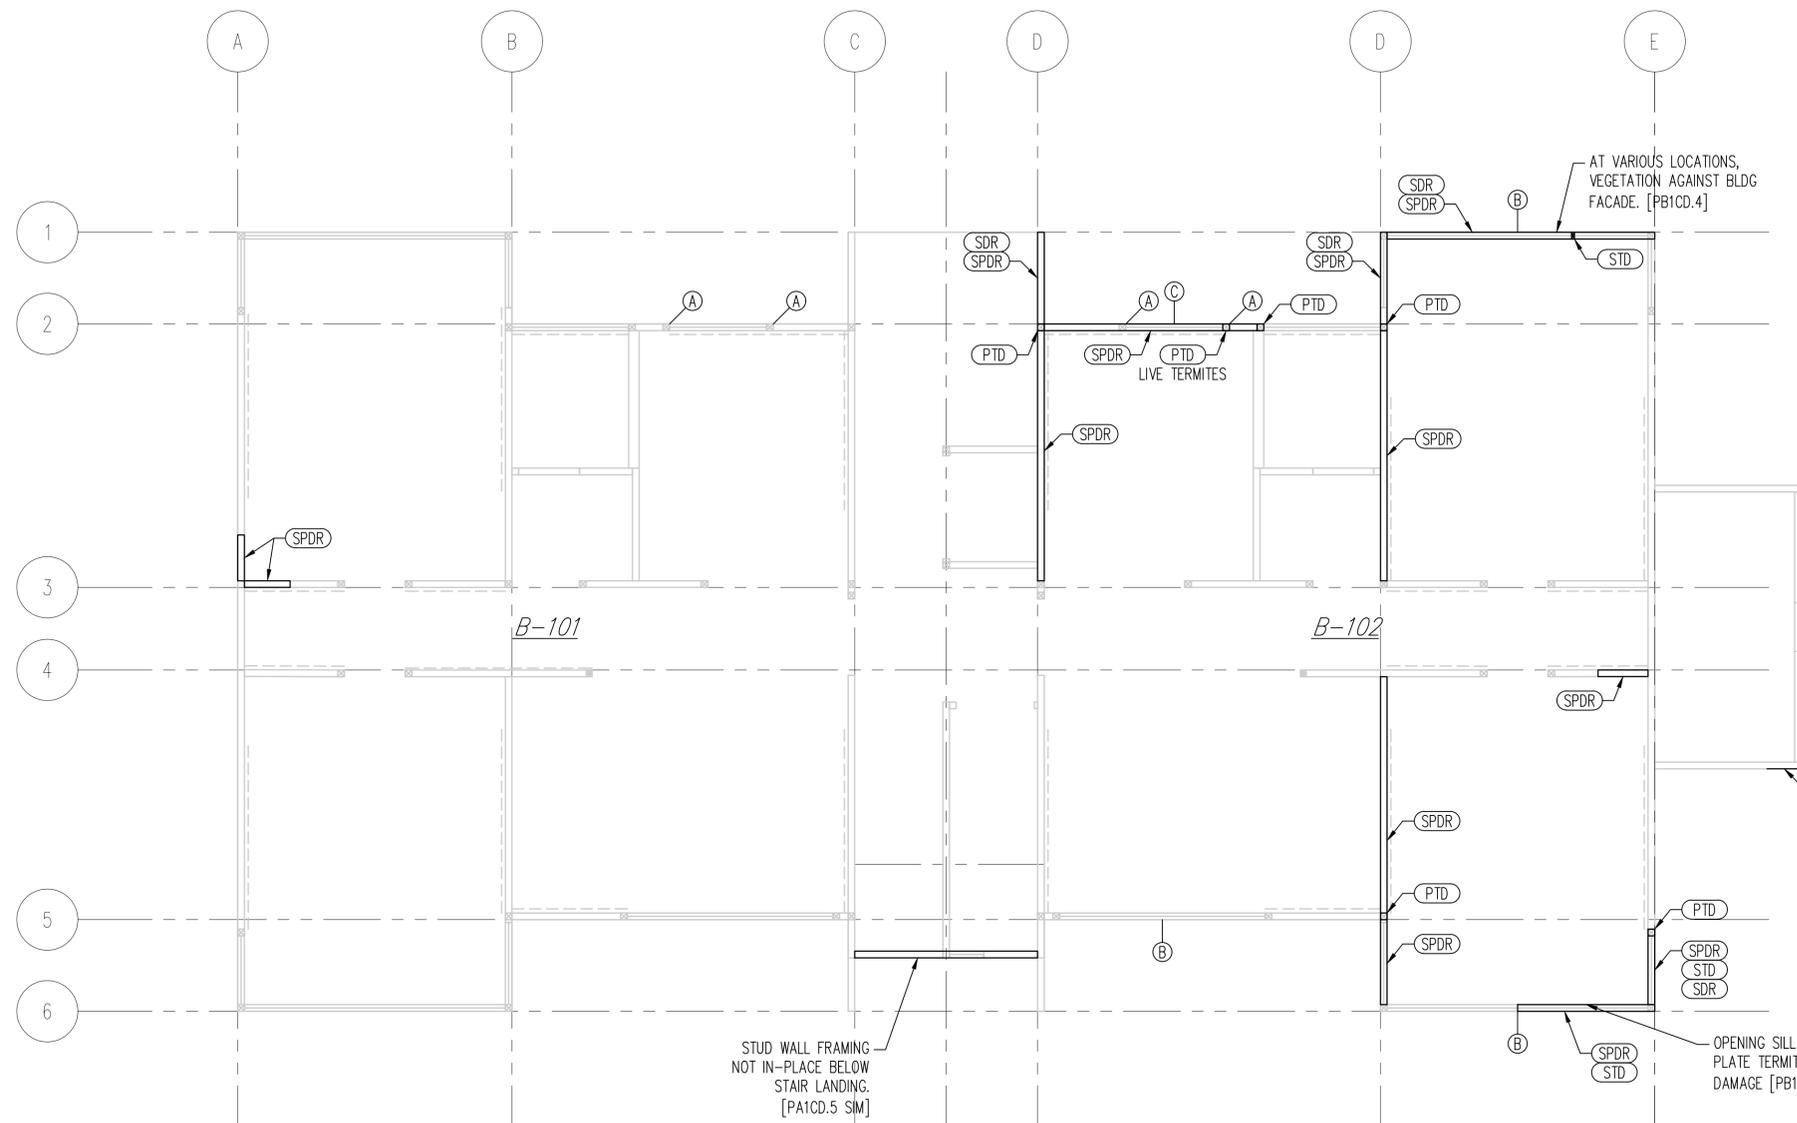

- LEGEND:**
 - SPDR SOLE PLATE DRY ROT. [PB1D.1]
 - SDR SIDING DRY ROT. [PB1D.2]
 - PTD POST TERMITE DAMAGE. [PB1D.3]
 - STD STUD TERMITE DAMAGE. [PB1D.4]
 - BTD BEAM TERMITE DAMAGE. [PB1D.5]
 - P[#]I[#] PHOTO; SEE EXHIBIT B & PHOTO ID

GENERAL DAMAGE NOTES:

- TYPICALLY, STEEL LET-IN BRACES EXHIBIT MODERATE CORROSION. [PB1D.6]


CONSTRUCTION DEFECTS GENERAL NOTES:

- AT VARIOUS LOCATIONS, SOLE PLATE ANCHOR ROD NUTS ARE LOOSE.
- TYPICALLY, INTERIOR PARTITION WALL SOLE PLATE ANCHOR RODS ARE MISSING OR INSTALLED @ GREATER THAN 32" OC.
- AT VARIOUS LOCATIONS, SIDING IS LOOSE AT BOTTOM EDGE.
- AT VARIOUS LOCATIONS, FIRST STORY SIDING DAMAGED - DRY ROT, MISSING, BROKEN, OR TERMITE DAMAGE.

- (A) CONSTRUCTION DEFECTS LEGEND:**
- A. MISSING OPENING KING POST. [PB1CD.1]
 - B. OPENING SINGLE SILL PLATE. [PB1CD.2]
 - C. MISSING OPENING SILL PLATE. [PB1CD.3]
 - D. MISSING OPENING HEADER.
 - E. DISCONTINUOUS STUD.
 - F. DISCONTINUOUS TOP PLATE.

GENERAL PLAN NOTES:
FOR EXISTING BUILDING INFORMATION NOT SHOWN, SEE GENERAL NOTES, REFERENCED DRAWINGS.

1 EXIST BUILDING B FOUNDATION PLAN
S-4 1/4" = 1'-0"

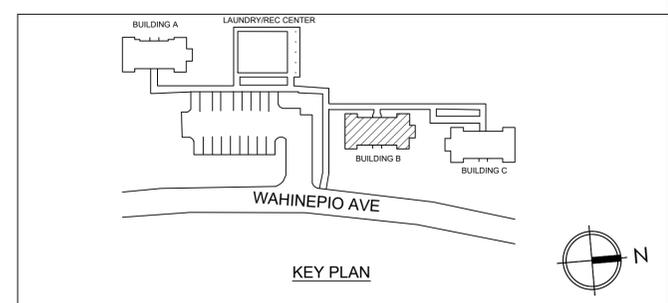

| REVISION NO. | DESCRIPTION | DATE | APPROVED |
|--------------|-------------|------|----------|
| | | | |


JOHN K. RITCHIEY
LICENSED PROFESSIONAL ENGINEER
PE 13256-S
HAWAII U.S.A.

COUNTY OF MAUI
DEPARTMENT OF HOUSING & HUMAN CONCERNS

EMERGENCY PROCLAMATION TO PROVIDE HOMELESS HOUSING - ANALYSIS PHASE
EP NO. 19-19
MAUI COUNTY, HI 96732
TMK: (2)3-8-007:11

BUILDING B PLANS

DRAWING NO.
S-4

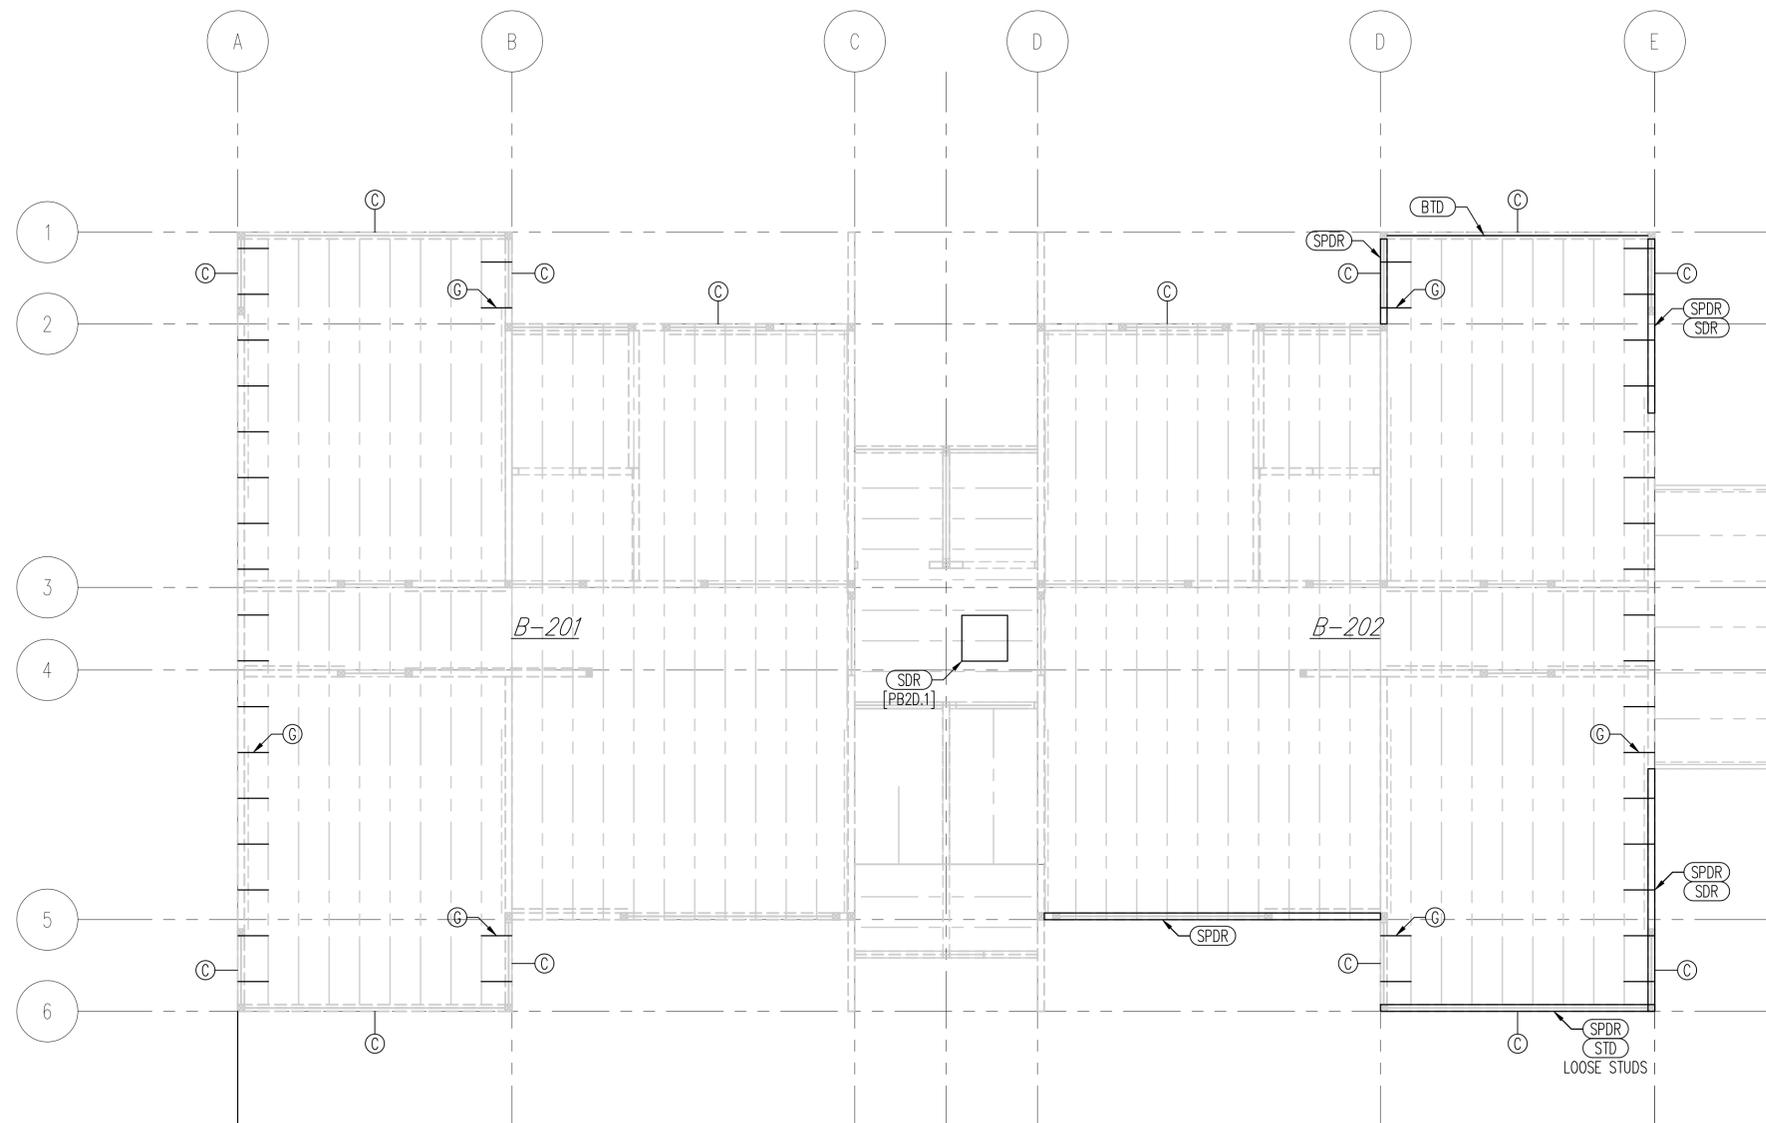


1 EXIST BUILDING B FLOOR FRAMING PLAN
 S-5 1/4" = 1'-0"

- LEGEND:**
- SPDR SOLE PLATE DRY ROT. [PB2D.2]
 - SDR SHING/SIDING DRY ROT. [PB2D.3]
 - PTD POST TERMITE DAMAGE.
 - STD STUD(S) TERMITE DAMAGE. [PB2D.4]
 - BTD BEAM TERMITE DAMAGE.
 - P[##] PHOTO; SEE EXHIBIT B & PHOTO ID

GENERAL DAMAGE NOTES:
 1. TYPICALLY, SOLE PLATE NAILING WAS NOT OBSERVED IN-PLACE.

- (A) CONSTRUCTION DEFECTS LEGEND:**
- A. MISSING OPENING KING POST.
 - B. OPENING SINGLE SILL PLATE.
 - C. MISSING OPENING SILL PLATE. [PB2CD.1]
 - D. MISSING OPENING HEADER.
 - E. DISCONTINUOUS STUD.
 - F. DISCONTINUOUS TOP PLATE.
 - G. MISSING BLOCKING. [PC2CD.2]

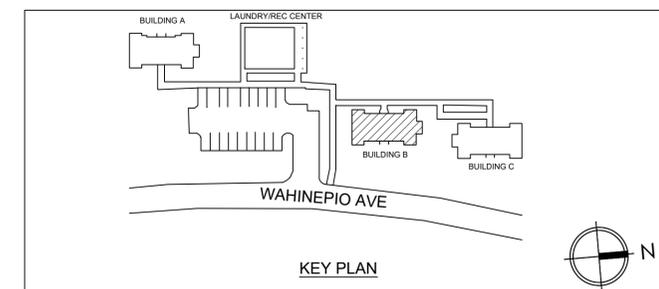

| REVISION NO. | DESCRIPTION | DATE | APPROVED |
|--------------|-------------|------|----------|
| | | | |

THIS WORK WAS PREPARED BY ME OR UNDER MY SUPERVISION AND CONSTRUCTION OF THIS PROJECT WILL BE UNDER MY OBSERVATION

J. Ritchey
 SIGNATURE

COUNTY OF MAUI
 DEPARTMENT OF HOUSING & HUMAN CONCERNS

EMERGENCY PROCLAMATION TO PROVIDE HOMELESS HOUSING - ANALYSIS PHASE
 EP NO. 19-19
 MAUI COUNTY, HI 96732
 TMK: (2)3-8-007:11

BUILDING B PLANS

308 PULUHI ST.
 KAHULUI, MAUI, HAWAII
 96732
 P: 808.727.2839
 E: JR@JRSE.COM

DRAWING NO.
S-5


4/30/2020
 EXP. DATE OF THE LICENSE

LEGEND:


- (BDR) BEAM DRY ROT
- (BTD) BEAM TERMITE DAMAGE. [PBRD.1]
- P[#][#] PHOTO; SEE EXHIBIT B & PHOTO ID

CONSTRUCTION DEFECTS GENERAL NOTES:

1. TYPICALLY, TRUSS WEB ARE UN-BRACED.
2. AT VARIOUS LOCATIONS, DAYLIGHT IS OBSERVED AT RIDGE.
3. GABLE END WALL IS UN-BRACED.

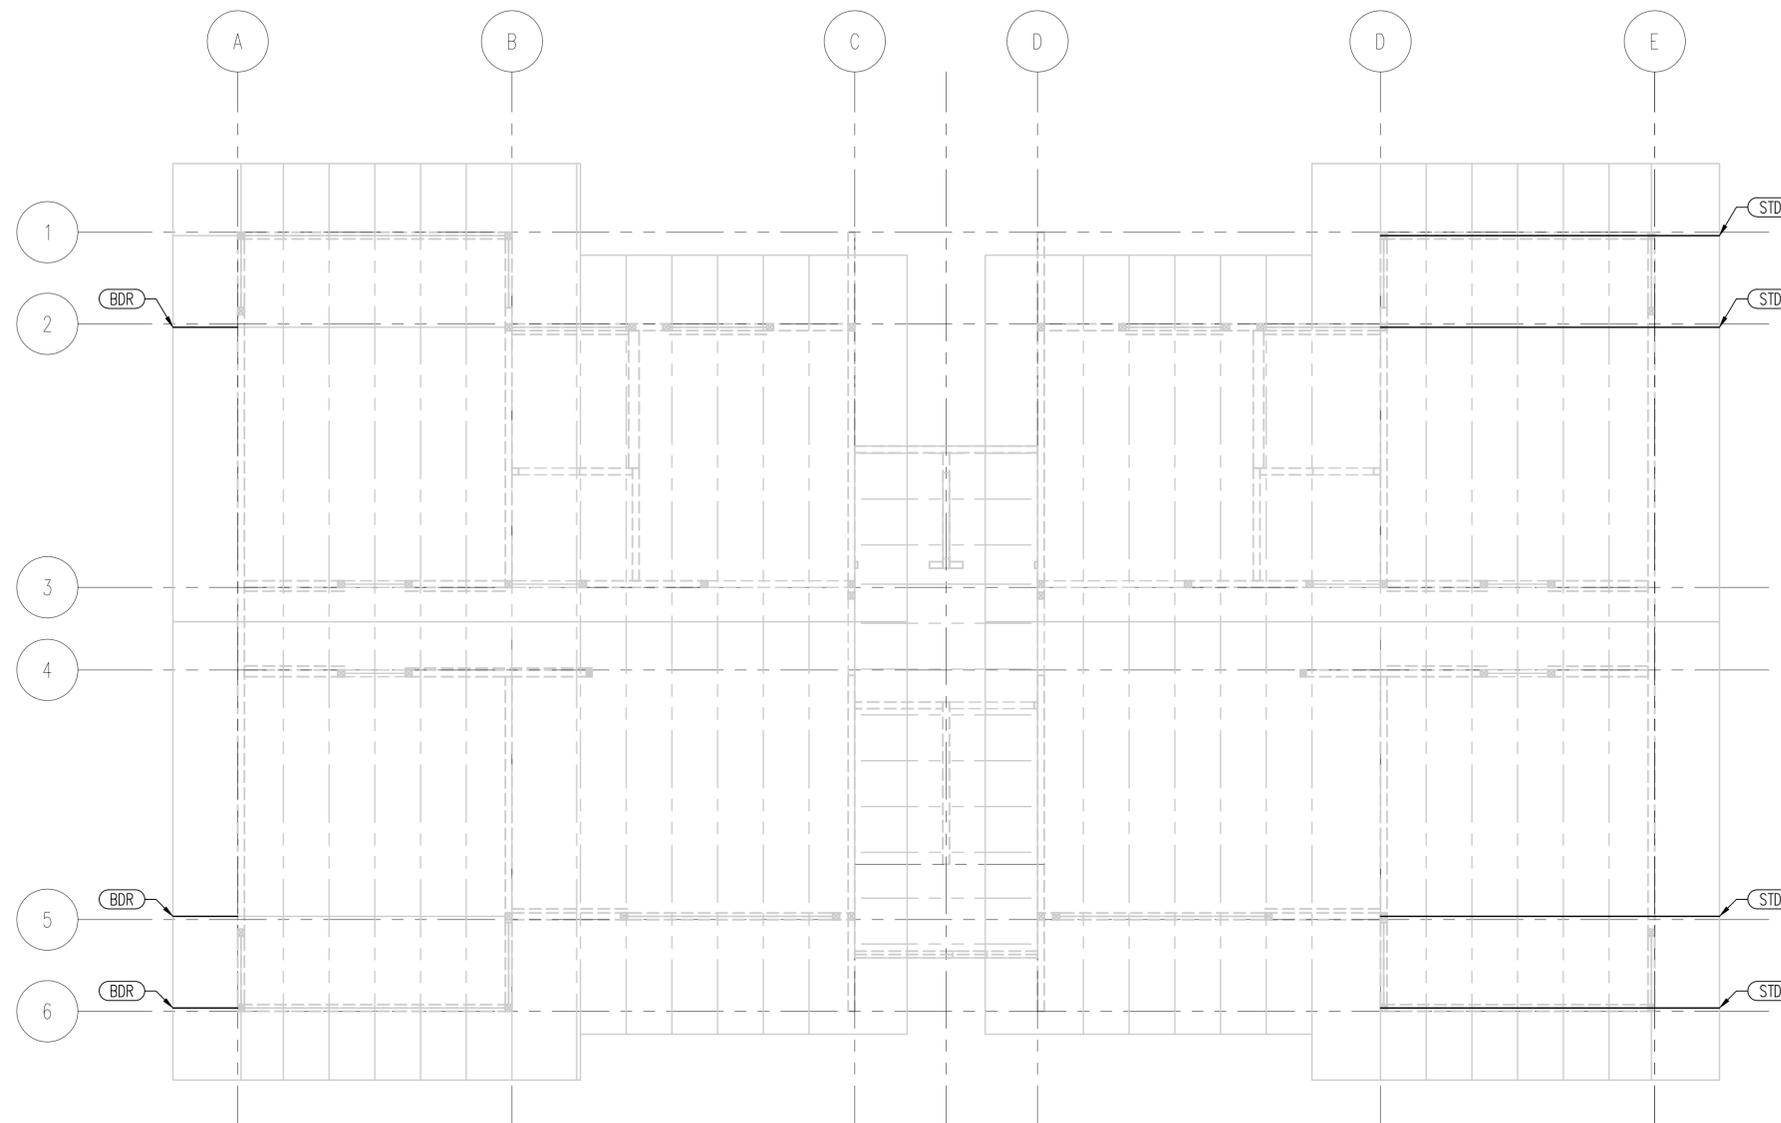

1 EXIST BUILDING B ROOF FRAMING PLAN
S-6 1/4" = 1'-0"

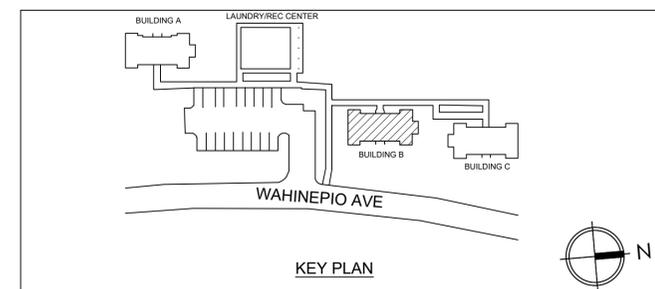

| REVISION NO. | DESCRIPTION | DATE | APPROVED |
|--------------|-------------|------|----------|
| | | | |



THIS WORK WAS PREPARED BY ME OR UNDER MY SUPERVISION AND CONSTRUCTION OF THIS PROJECT WILL BE UNDER MY OBSERVATION


SIGNATURE: *J. Ritchey*
EXP. DATE OF THE LICENSE: 4/30/2020

COUNTY OF MAUI
DEPARTMENT OF HOUSING & HUMAN CONCERNS
EMERGENCY PROCLAMATION TO PROVIDE HOMELESS HOUSING - ANALYSIS PHASE
EP NO. 19-19
MAUI COUNTY, HI 96732
TMK: (2)3-8-007:11

BUILDING B PLANS

308 PULUH ST.
KAHULUI, MAUI, HAWAII
96732
P: 808.727.2839
E: JR@JRSE.ENGINEER

DRAWING NO.
S-6

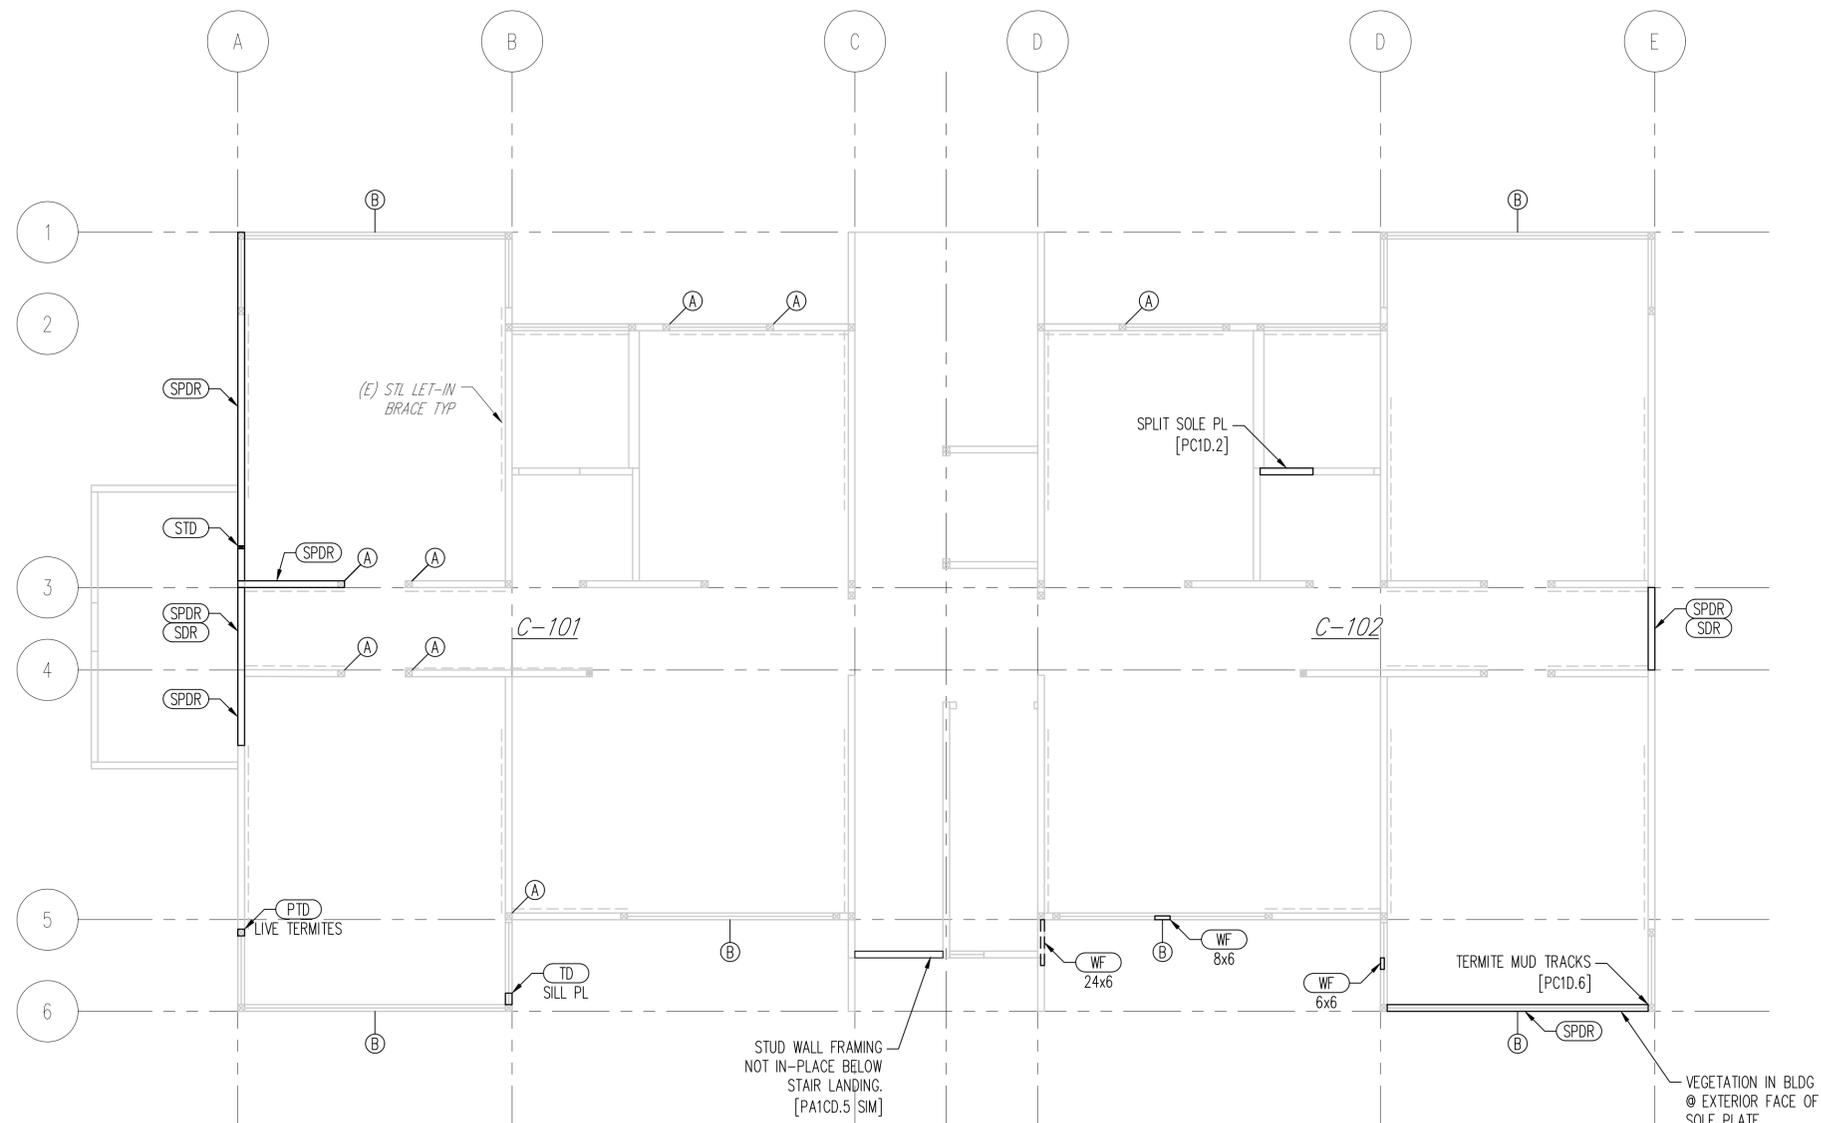

1 EXIST BUILDING C FOUNDATION PLAN
S-4 1/4" = 1'-0"

- LEGEND:**
- WF LENGTH x HEIGHT DENOTES CONCRETE SPALL OR DELAMINATION AT WALL FACE WITH EXPOSED CORRODED REBAR [PC1D.1]
 - SPDR SOLE PLATE DRY ROT
 - SDR SIDING DRY ROT [PC1D.3]
 - PTD POST TERMITE DAMAGE [PC1D.4]
 - STD STUD TERMITE DAMAGE [PC1D.5]
 - BTD BEAM TERMITE DAMAGE [PC1D.6]
 - TD TERMITE DAMAGE
 - P[#I##] PHOTO; SEE EXHIBIT C & PHOTO ID

GENERAL DAMAGE NOTES:


- TYPICALLY, STEEL LET-IN BRACES EXHIBIT MODERATE CORROSION.

GENERAL CONSTRUCTION DEFECTS NOTES:

- AT VARIOUS LOCATIONS, SOLE PLATE ANCHOR ROD NUTS ARE LOOSE.
- TYPICALLY, INTERIOR PARTITION WALL SOLE PLATE ANCHOR RODS ARE MISSING OR INSTALLED @ GREATER THAN 32" OC.
- AT VARIOUS LOCATIONS, SIDING IS LOOSE AT BOTTOM EDGE.
- AT VARIOUS LOCATIONS, FIRST STORY SIDING DAMAGED - DRY ROT, MISSING, BROKEN, OR TERMITE DAMAGE.
- AT VARIOUS LOCATIONS, VEGETATION AGAINST BUILDING FACADE. [PC1D.3]

- CONSTRUCTION DEFECTS LEGEND:**
- A. MISSING OPENING KING POST [PC1CD.1]
 - B. OPENING SINGLE SILL PLATE [PC1CD.2]
 - C. MISSING OPENING SILL PLATE
 - D. MISSING OPENING HEADER
 - E. DISCONTINUOUS STUD
 - F. DISCONTINUOUS TOP PLATE

GENERAL PLAN NOTES:
FOR EXISTING BUILDING INFORMATION NOT SHOWN, SEE GENERAL NOTES, REFERENCED DRAWINGS.

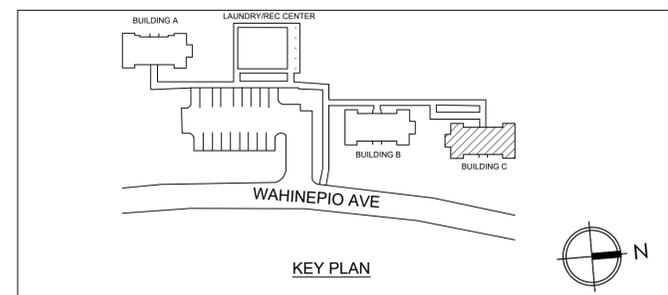

| REVISION NO. | DESCRIPTION | DATE | APPROVED |
|--------------|-------------|------|----------|
| | | | |


JOHN K. RITCHIEY
LICENSED PROFESSIONAL ENGINEER
PE 13256-S
HAWAII U.S.A.

COUNTY OF MAUI
DEPARTMENT OF HOUSING & HUMAN CONCERNS

EMERGENCY PROCLAMATION TO PROVIDE HOMELESS HOUSING - ANALYSIS PHASE
EP NO. 19-19
MAUI COUNTY, HI 96732
TMK: (2)3-8-007:11

BUILDING C PLANS

THIS WORK WAS PREPARED BY ME OR UNDER MY SUPERVISION AND CONSTRUCTION OF THIS PROJECT WILL BE UNDER MY OBSERVATION

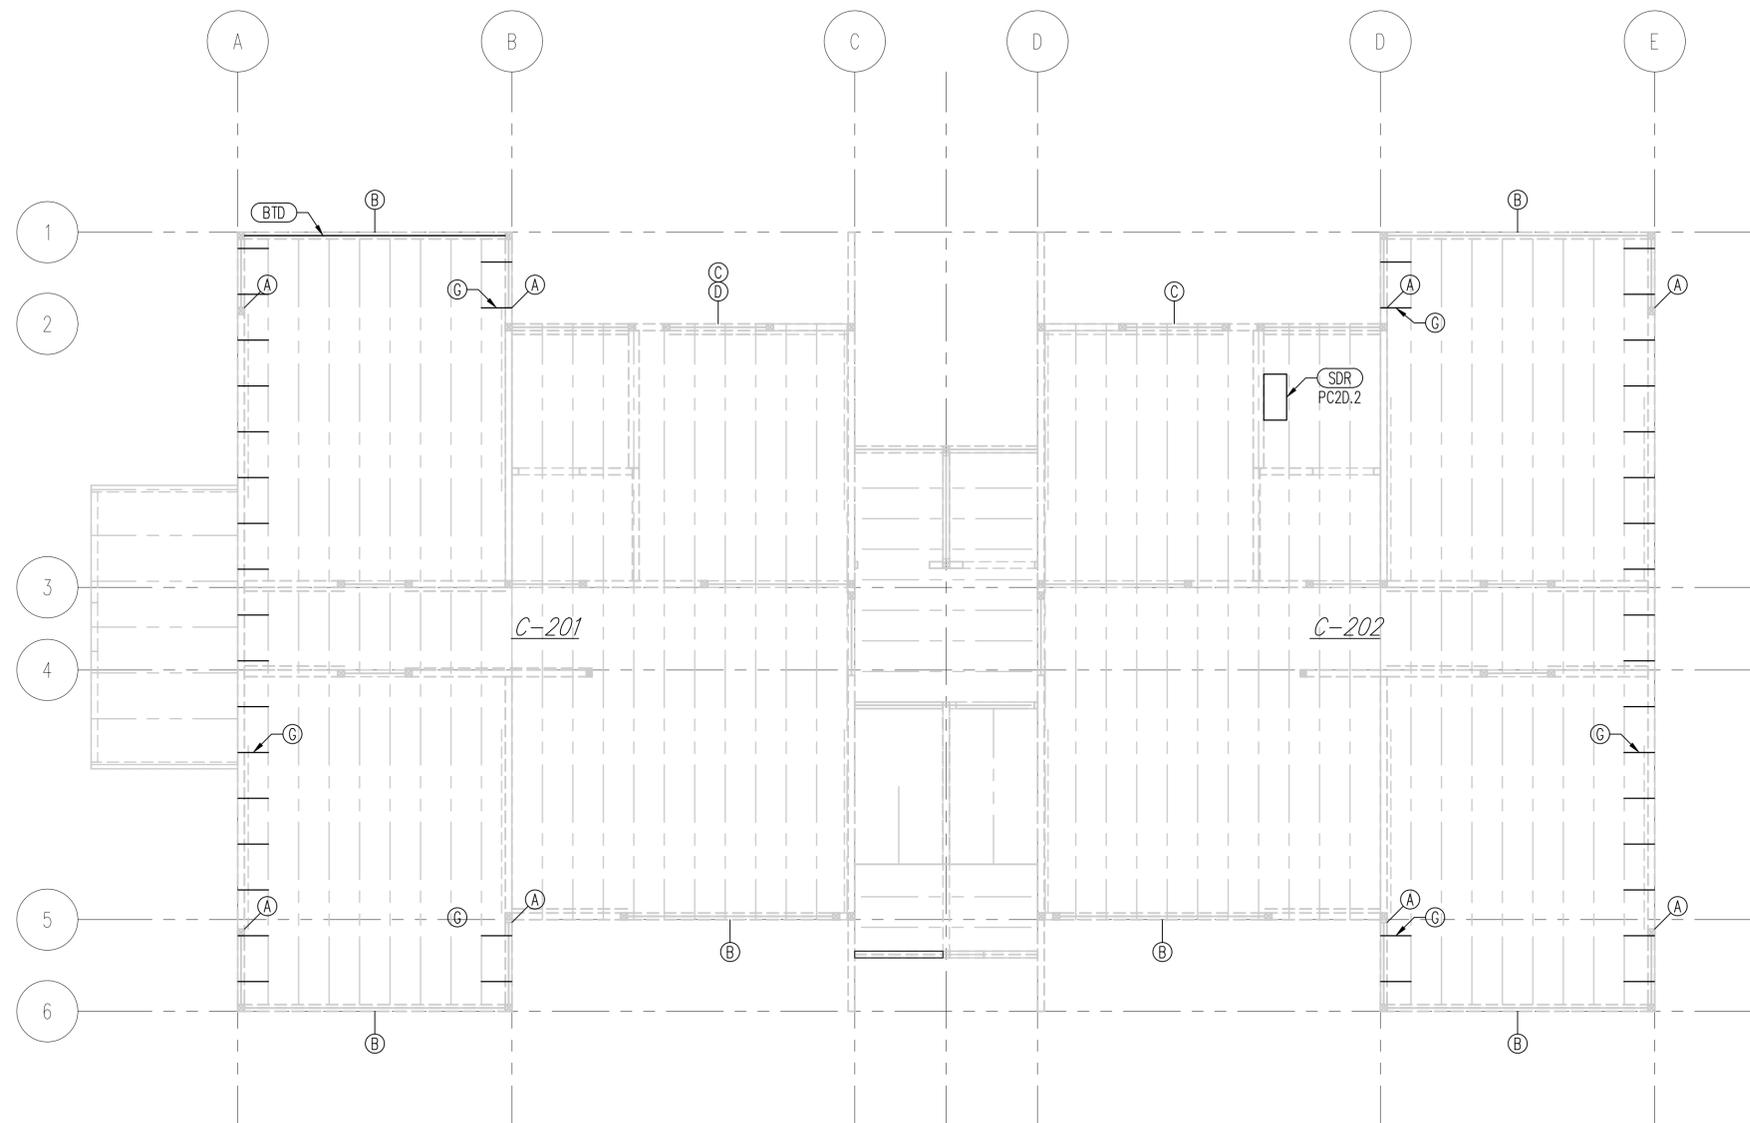

- LEGEND:**
- (SPDR) SOLE PLATE DRY ROT
 - (SDR) SHING/SIDING DRY ROT
 - (PTD) POST TERMITE DAMAGE
 - (STD) STUD(S) TERMITE DAMAGE
 - (BTD) BEAM TERMITE DAMAGE [PC2D.1]
 - P[##] PHOTO; SEE EXHIBIT C & PHOTO ID

GENERAL DAMAGE NOTES:


- TYPICALLY, STEEL LET-IN BRACES EXHIBIT MODERATE CORROSION.

GENERAL CONSTRUCTION DEFECTS NOTES:

- AT VARIOUS LOCATIONS, SOLE PLATE ANCHOR ROD NUTS ARE LOOSE.
- TYPICALLY, INTERIOR AND EXTERIOR WALL SOLE PLATE ANCHORAGE WAS NOT OBSERVED IN-PLACE.

- (A) CONSTRUCTION DEFECTS LEGEND:**
- A. MISSING OPENING KING POST. [PC2CD.1]
 - B. OPENING SINGLE SILL PLATE. [PC2CD.2]
 - C. MISSING OPENING SILL PLATE. [PC2CD.3]
 - D. MISSING OPENING HEADER. [PC2CD.4]
 - E. DISCONTINUOUS STUD.
 - F. DISCONTINUOUS TOP PLATE.
 - G. MISSING BLOCKING.

1 EXIST BUILDING C FLOOR FRAMING PLAN
 S-5 1/4" = 1'-0"

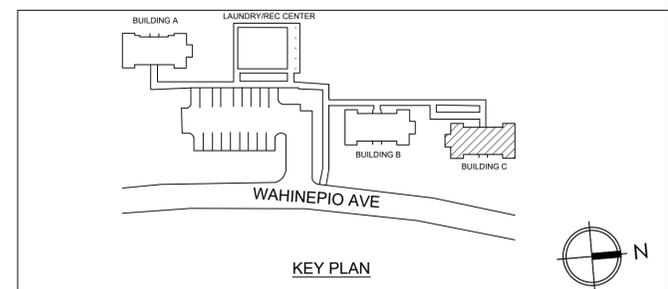

| REVISION NO. | DESCRIPTION | DATE | APPROVED |
|--------------|-------------|------|----------|
| | | | |



THIS WORK WAS PREPARED BY ME OR UNDER MY SUPERVISION AND CONSTRUCTION OF THIS PROJECT WILL BE UNDER MY OBSERVATION

John K. Ritchey
 SIGNATURE

COUNTY OF MAUI
 DEPARTMENT OF HOUSING & HUMAN CONCERNS
 EMERGENCY PROCLAMATION TO PROVIDE HOMELESS HOUSING - ANALYSIS PHASE
 EP NO. 19-19
 MAUI COUNTY, HI 96732
 TMK: (2)3-8-007:11

BUILDING C PLANS

DRAWING NO.
S-8


308 PULUHI ST.
 KAHULUI, MAUI, HAWAII
 96732
 P: 808.727.2839
 E: JR@JRSE.ENGINEER
 JOHN RITCHIEY, STRUCTURAL ENGINEER LLC
 EXP. DATE OF THE LICENSE: 4/30/2020

LEGEND:


- (BDR) BEAM DRY ROT [PCRD.1]
- (BTD) BEAM TERMITE DAMAGE
- P[#][#] PHOTO; SEE EXHIBIT C & PHOTO ID

CONSTRUCTION DEFECTS GENERAL NOTES:

1. TYPICALLY, TRUSS WEB ARE UN-BRACED.
2. AT VARIOUS LOCATIONS, DAYLIGHT IS OBSERVED AT RIDGE.
3. GABLE END WALL IS UN-BRACED.

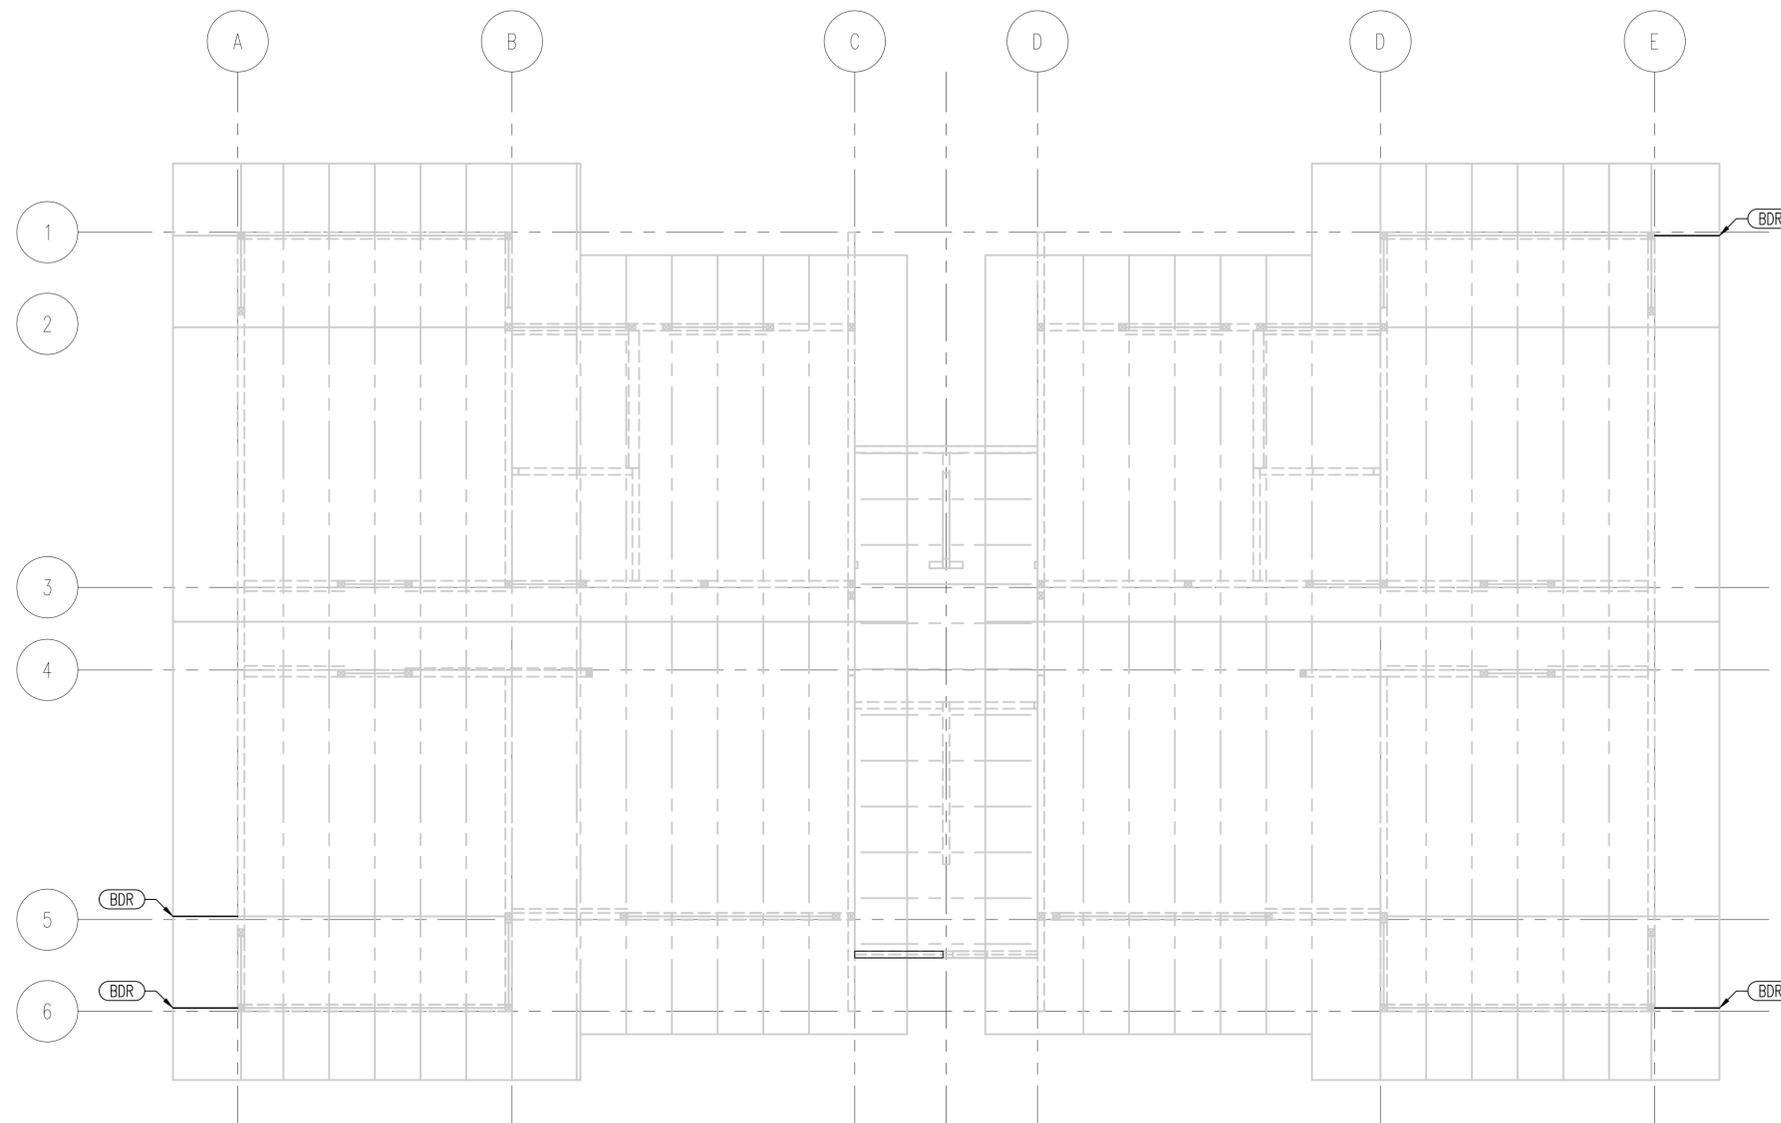

1 EXIST BUILDING C ROOF FRAMING PLAN
S-6 1/4" = 1'-0"

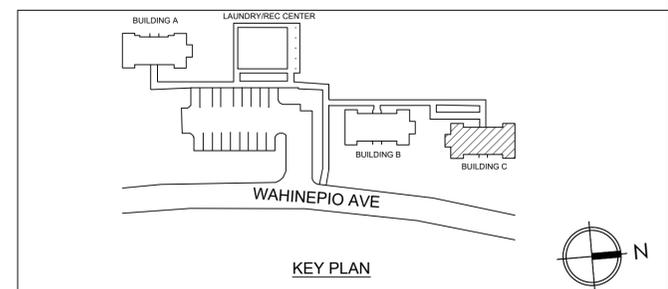

| REVISION NO. | DESCRIPTION | DATE | APPROVED |
|--------------|-------------|------|----------|
| | | | |

JOHN K. RITCHIEY
LICENSED PROFESSIONAL ENGINEER
PE 13256-S
HAWAII U.S.A.

COUNTY OF MAUI
DEPARTMENT OF HOUSING & HUMAN CONCERNS

EMERGENCY PROCLAMATION TO PROVIDE HOMELESS HOUSING - ANALYSIS PHASE
EP NO. 19-19
MAUI COUNTY, HI 96732
TMK: (2)3-8-007:11

BUILDING C PLANS


THIS WORK WAS PREPARED BY ME OR UNDER MY SUPERVISION AND CONSTRUCTION OF THIS PROJECT WILL BE UNDER MY OBSERVATION

SIGNATURE EXP. DATE OF THE LICENSE: 4/30/2020

DRAWING NO.
S-9

308 PULUH ST.
 KAHULUI, MAUI, HAWAII
 96732
 P: 808.727.2839
 E: JR@JRSE.ENGINEER

JOHN RITCHIEY, STRUCTURAL ENGINEER LLC SHEET 10 OF 12

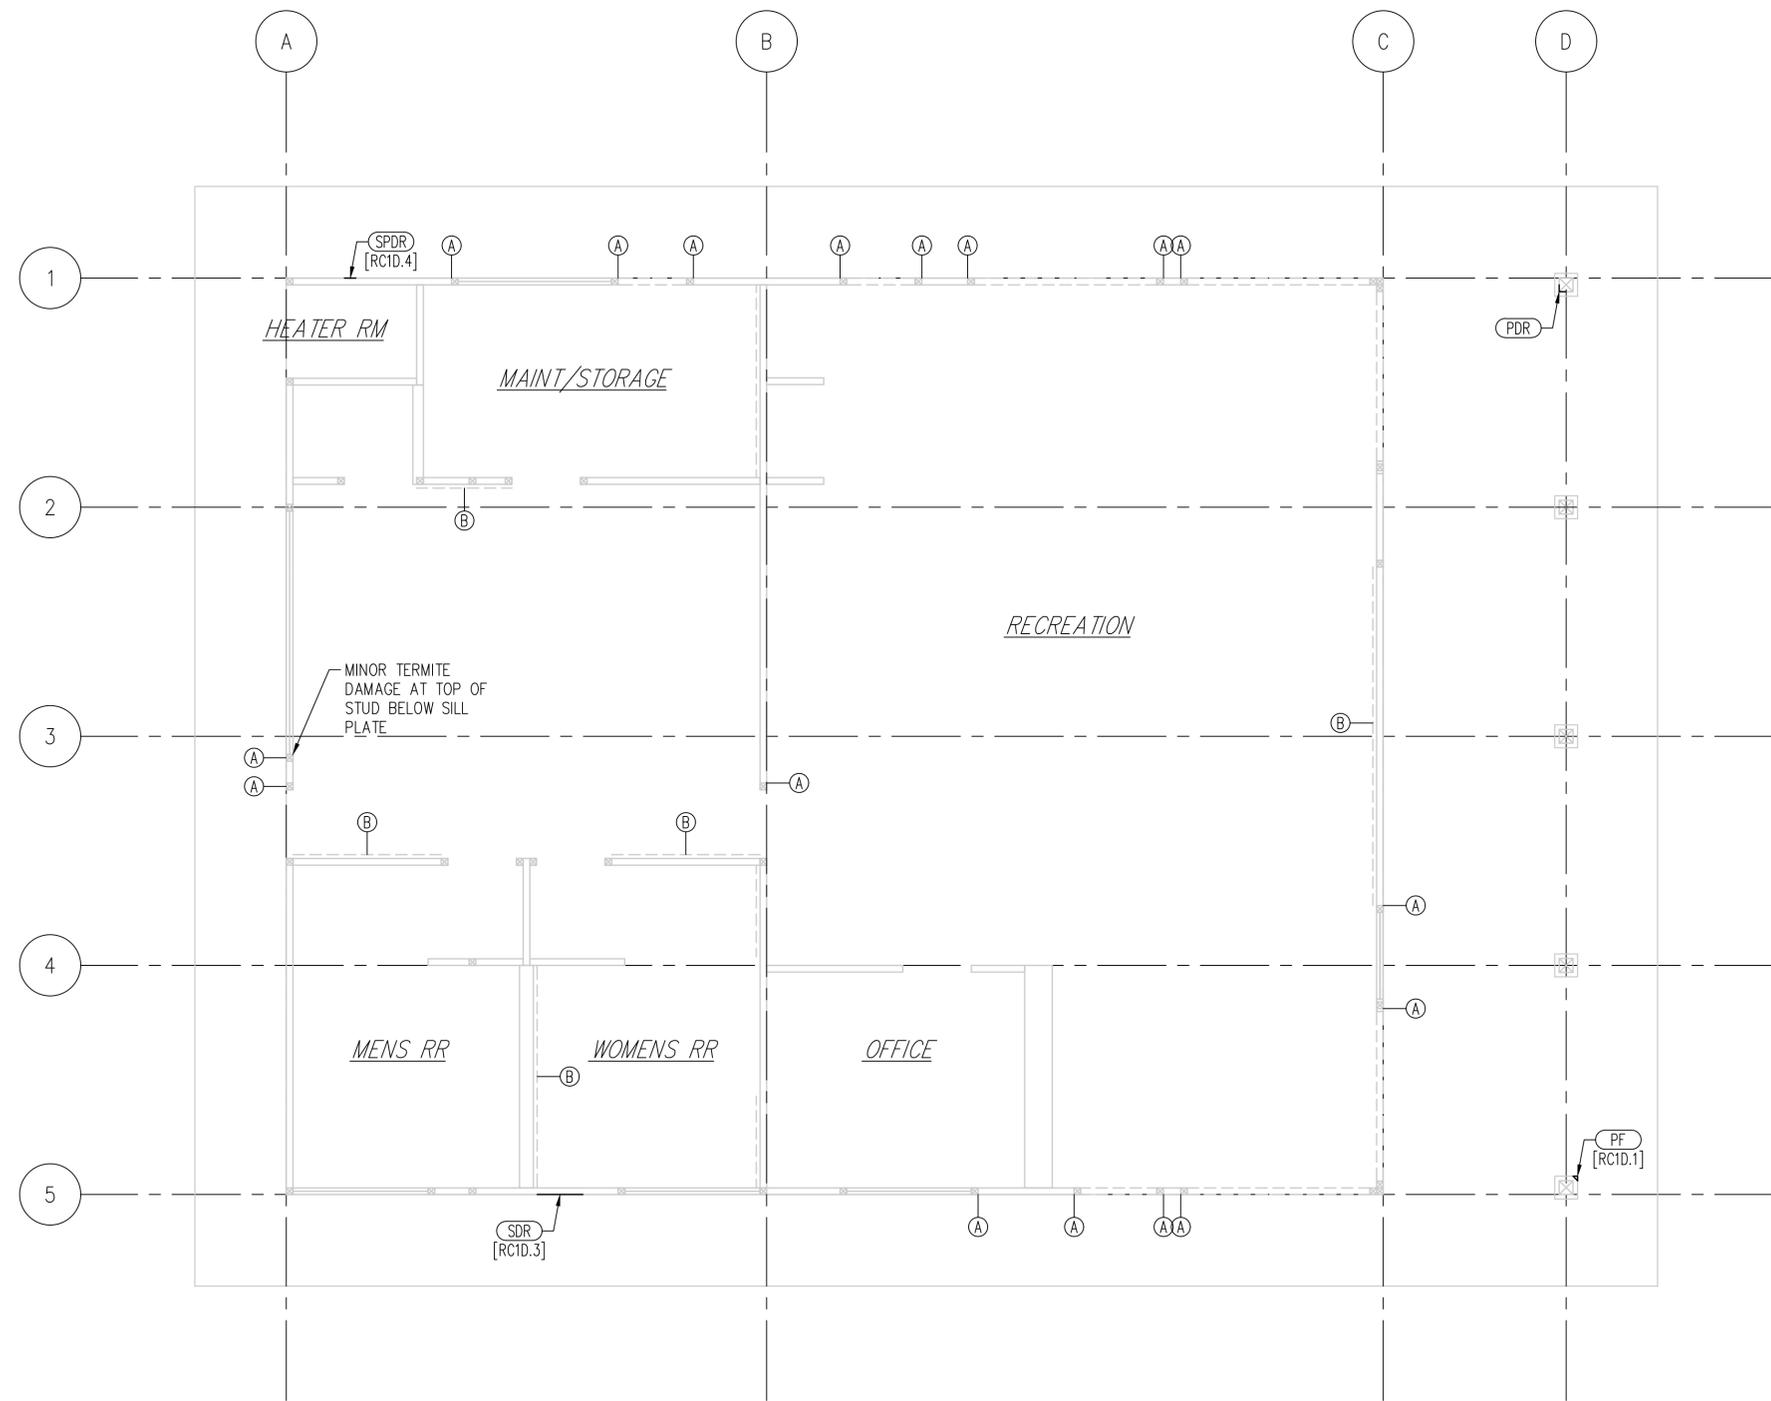


- LEGEND:**
- PF DENOTES CONCRETE SPALL OR DELAMINATION AT PIER FACE [PA1D.2]
 - LENGTH x HEIGHT
 - SDR SIDING DRY ROT
 - PTD POST TERMITE DAMAGE
 - PDR POST DRY ROT
 - BTD BEAM TERMITE DAMAGE
 - SPDR SOLE PLATE DRY ROT
 - [#] PHOTO; SEE EXHIBIT D & PHOTO ID

GENERAL CONSTRUCTION DEFECTS NOTES:
 1. TYPICALLY, INTERIOR PARTITION WALL SOLE PLATE ANCHOR RODS ARE MISSING OR INSTALLED @ GREATER THAN 32" OC. [RC1D.1]

- CONSTRUCTION DEFECTS LEGEND:**
 A. MISSING OPENING KING POST. [RC1D.6]
 B. MISSING LET-IN BRACE [RC1D.3]

GENERAL PLAN NOTES:
 FOR EXISTING BUILDING INFORMATION NOT SHOWN, SEE GENERAL NOTES, REFERENCED DRAWINGS.

1 EXIST LAUNDRY/RECREATIONAL CENTER BUILDING FOUNDATION PLAN
 S-10 1/4" = 1'-0"

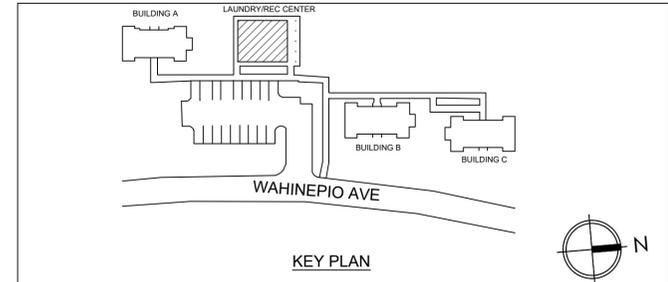

| REVISION NO. | DESCRIPTION | DATE | APPROVED |
|--------------|-------------|------|----------|
| | | | |

THIS WORK WAS PREPARED BY ME OR UNDER MY SUPERVISION AND CONSTRUCTION OF THIS PROJECT WILL BE UNDER MY OBSERVATION

John K. Ritchey
 SIGNATURE

COUNTY OF MAUI
 DEPARTMENT OF HOUSING & HUMAN CONCERNS

EMERGENCY PROCLAMATION TO PROVIDE HOMELESS HOUSING - ANALYSIS PHASE
 EP NO. 19-19
 MAUI COUNTY, HI 96732
 TMK: (2)3-8-007:11

LAUNDRY/RECREATIONAL CENTER DAMAGE PLANS

308 PULUH ST.
 KAHULUI, MAUI, HAWAII 96732
 P: 808.727.2839
 E: JR@JRSE.ENGINEER

JOHN RITCHIEY, STRUCTURAL ENGINEER LLC
 JOHN RITCHIEY, STRUCTURAL ENGINEER

DRAWING NO. S-10

4/30/2020
 EXP. DATE OF THE LICENSE

LEGEND:


- (BTD) BEAM TERMITE DAMAGE
- [##] PHOTO; SEE EXHIBIT A & PHOTO ID

GENERAL CONSTRUCTION DEFECTS NOTES:


1. TYPICALLY, TRUSS WEB ARE UN-BRACED. [RCRD.1]
2. GABLE END WALLS ARE UNFRAMED. [RCRD.2]

(A) CONSTRUCTION DEFECTS LEGEND:

- A. MISSING DOUBLE TOP PLATE HEADER ABOVE DOOR OR WINDOW. [RC1CD.7]

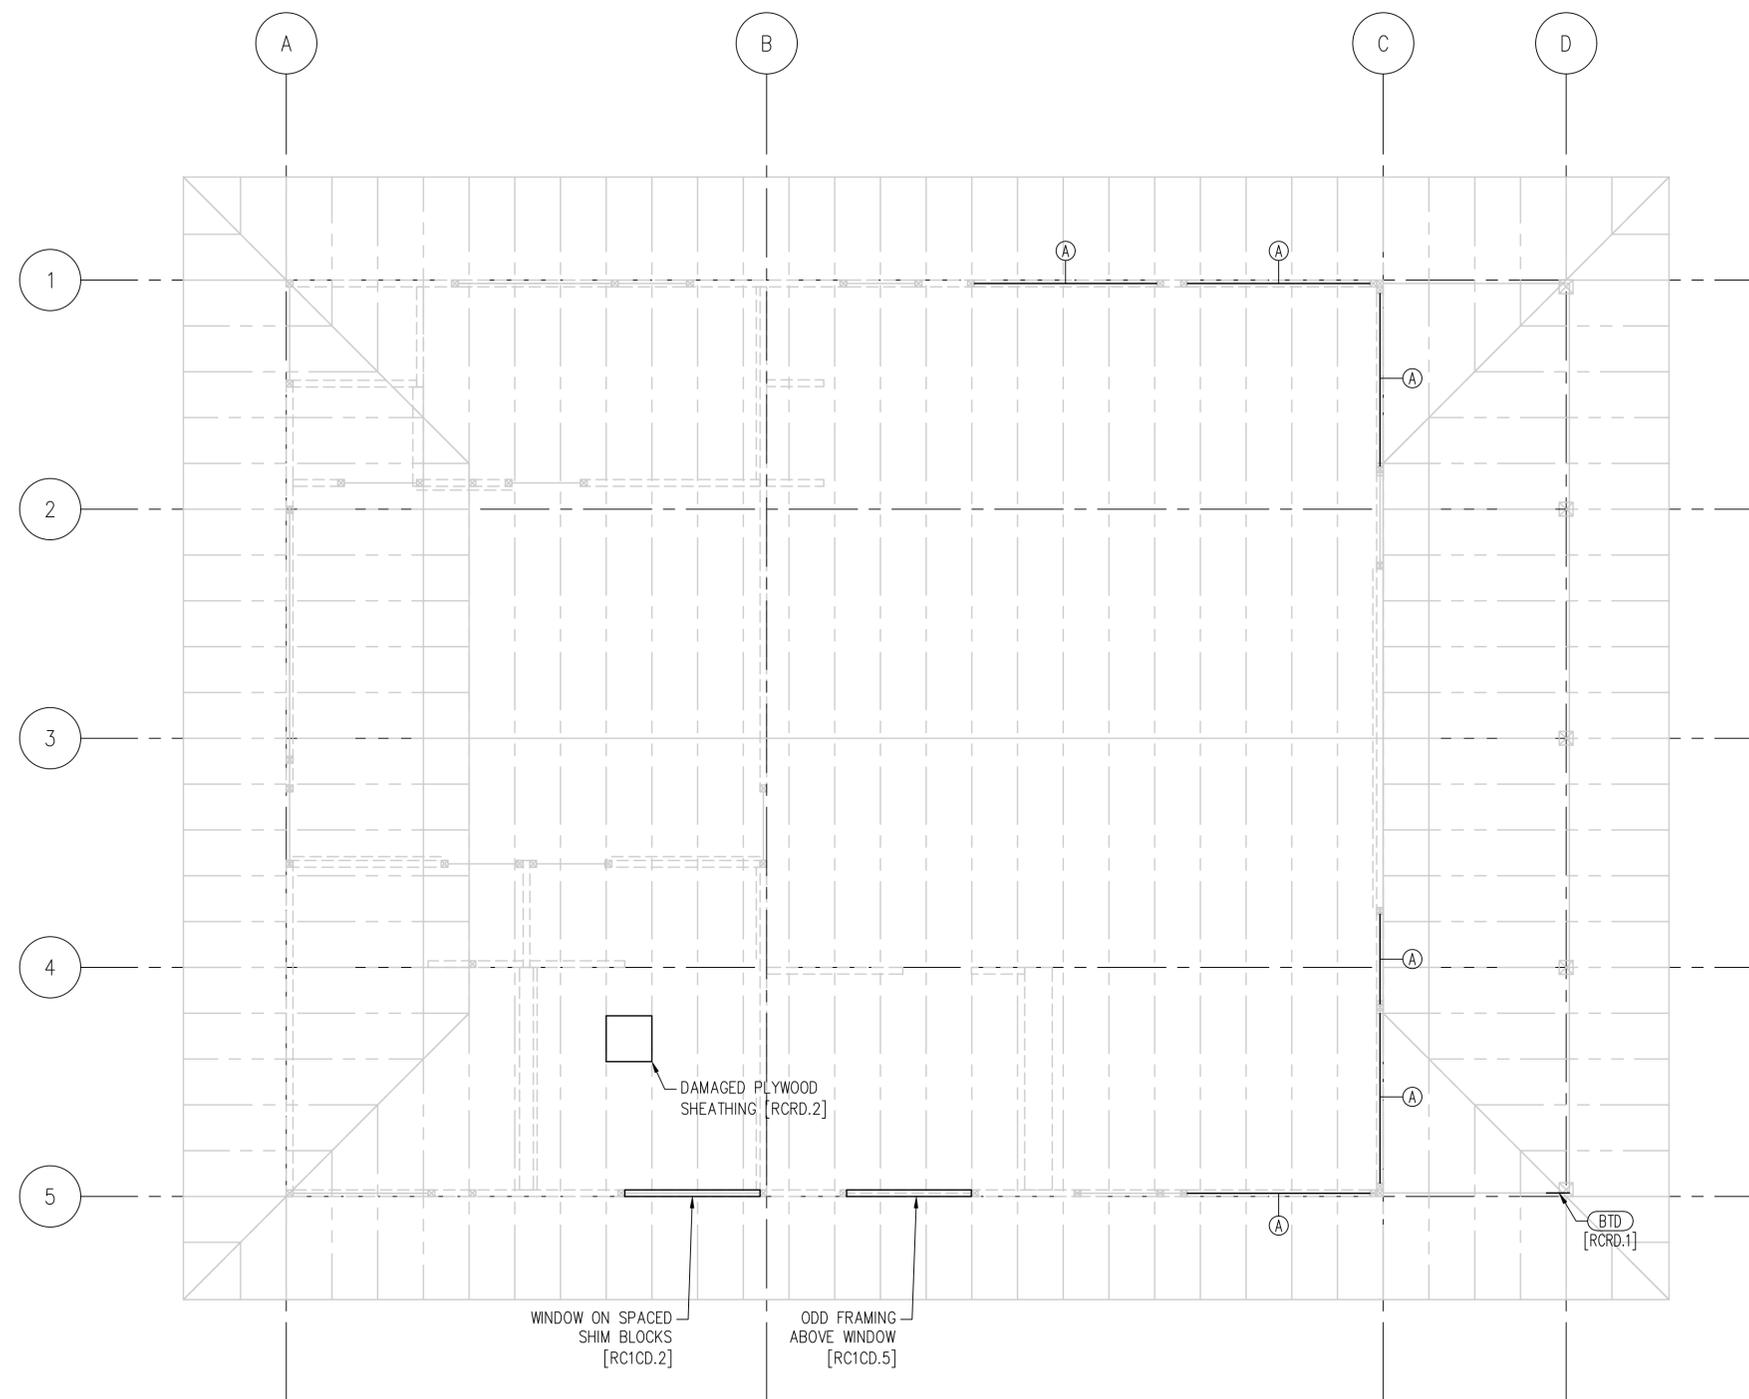

1 EXIST LAUNDRY/RECREATIONAL CENTER BUILDING ROOF FRAMING PLAN
S-11 1/4" = 1'-0"

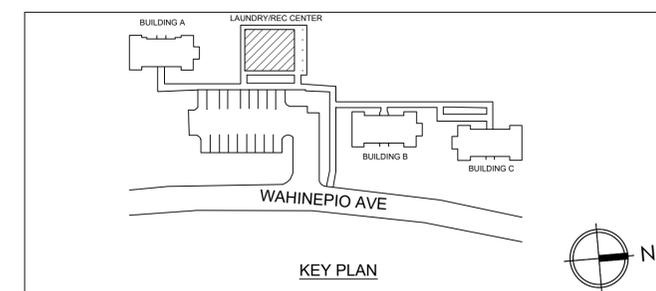

| REVISION NO. | DESCRIPTION | DATE | APPROVED |
|--------------|-------------|------|----------|
| | | | |



THIS WORK WAS PREPARED BY ME OR UNDER MY SUPERVISION AND CONSTRUCTION OF THIS PROJECT WILL BE UNDER MY OBSERVATION

John K. Ritchey
SIGNATURE

COUNTY OF MAUI
DEPARTMENT OF HOUSING & HUMAN CONCERNS
EMERGENCY PROCLAMATION TO PROVIDE HOMELESS HOUSING - ANALYSIS PHASE
EP NO. 19-19
MAUI COUNTY, HI 96732
TMK: (2)3-8-007:11

LAUNDRY/RECREATIONAL CENTER DAMAGE PLANS

308 PULUHI ST.
KAHULUI, MAUI, HAWAII
96732
P: 808.727.2839
E: JR@JRSE.ENGINEER

JOHN RITCHIEY, STRUCTURAL ENGINEER LLC

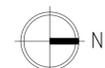




EXHIBIT G – FEE PROPOSALS

UHMC DORM REPLACEMENT-NEW DORM BUILDING

M19011

\$ 125.00

| Task | Day | Hours | Hours | Fee |
|--|-----|-------|------------|---------------------|
| Pre-Design | | | | |
| CORRESPONDANCE/MEETINGS | 1 | 6 | 6 | \$ 750.00 |
| REVIEW/STUDY DESIGN DOCUMENTS | 2 | 8 | 16 | \$ 2,000.00 |
| REVIEW/STUDY GEOTECHNCIAL REPORT | 1 | 4 | 4 | \$ 500.00 |
| SUBTOTAL | | | 26 | \$ 3,250.00 |
| TAX (HI G.E. TAX (4.166%)) | | | | \$ 135.40 |
| TOTAL | | | | \$ 3,385.40 |
| Structural Analysis | | | | |
| GRAVITY LOADS | 1 | 2 | 2 | \$ 250.00 |
| WIND | 1 | 2 | 2 | \$ 250.00 |
| SEISMIC | 1 | 2 | 2 | \$ 250.00 |
| GRAVITY FORCE RESISTING SYSTEM | 2 | 8 | 16 | \$ 2,000.00 |
| UPLIFT FORCE RESISTING SYSTEM | 1 | 6 | 6 | \$ 750.00 |
| LATERAL FORCE REISITING SYSTEM | 3 | 8 | 24 | \$ 3,000.00 |
| FOUNDATION DESIGN | 1 | 8 | 8 | \$ 1,000.00 |
| SUBTOTAL | | | 60 | \$ 7,500.00 |
| TAX (HI G.E. TAX (4.166%)) | | | | \$ 312.45 |
| TOTAL | | | | \$ 7,812.45 |
| Plans and Specifications | | | | |
| CONVERSION OF CONSULTANT DRAWINGS | 1 | 10 | 10 | \$ 1,250.00 |
| ROOF PLAN | 2 | 8 | 16 | \$ 2,000.00 |
| FLOOR PLAN | 2 | 8 | 16 | \$ 2,000.00 |
| FOUNDATION PLAN | 2 | 8 | 16 | \$ 2,000.00 |
| GENERAL NOTES | 1 | 6 | 6 | \$ 750.00 |
| TYPICAL DETAILS | 2 | 8 | 16 | \$ 2,000.00 |
| FOUNDATION DETAILS | 1 | 8 | 8 | \$ 1,000.00 |
| FLOOR DETAILS | 2 | 8 | 16 | \$ 2,000.00 |
| ROOF DETAILS | 2 | 8 | 16 | \$ 2,000.00 |
| MISCELLANEOUS DETAILS | 2 | 8 | 16 | \$ 2,000.00 |
| SPECIFICATIONS | 3 | 8 | 24 | \$ 3,000.00 |
| COORDINATION WITH OTHER CONSULTANTS | 2 | 8 | 16 | \$ 2,000.00 |
| COM REVIEW COMMENTS | 1 | 6 | 6 | \$ 750.00 |
| REVISIONS TO DRAWINGS | 1 | 8 | 8 | \$ 1,000.00 |
| REVISIONS TO SPECIFICATIONS | 1 | 8 | 8 | \$ 1,000.00 |
| QA/QC - FINAL COORDINATION | 1 | 8 | 8 | \$ 1,000.00 |
| PERMIT SUBMITTAL | 1 | 4 | 4 | \$ 500.00 |
| SUBTOTAL | | | 210 | \$ 26,250.00 |
| TAX (HI G.E. TAX (4.166%)) | | | | \$ 1,093.58 |
| TOTAL | | | | \$ 27,343.58 |
| Re-use of Drawings | | | | |
| REUSE FACTOR (2 DORM BUILDINGS, 3 TOTAL) | | | | 0.25 |
| SUBTOTAL | | | | \$ 8,437.50 |
| TAX (HI G.E. TAX (4.166%)) | | | | \$ 351.51 |
| TOTAL | | | | \$ 8,789.01 |
| Permitting | | | | |
| CORRESPONDANCE/MEETINGS | 1 | 10 | 10 | \$ 1,250.00 |
| REVISIONS TO DRAWINGS | 3 | 8 | 24 | \$ 3,000.00 |
| RESPONSES TO RFIs | 2 | 8 | 16 | \$ 2,000.00 |
| REVISIONS TO SPECIFICATIONS | 3 | 8 | 24 | \$ 3,000.00 |
| SUBTOTAL | | | 74 | \$ 9,250.00 |
| TAX (HI G.E. TAX (4.166%)) | | | | \$ 385.36 |
| TOTAL | | | | \$ 9,635.36 |
| Construction Administration | | | | |
| SITE VISITS / OBSERVATION | 12 | 3 | 36 | \$ 4,500.00 |
| SUBMITTAL REVIEWS | 1 | 10 | 10 | \$ 1,250.00 |
| RESPONSES TO RFIs | 1 | 10 | 10 | \$ 1,250.00 |
| AS BUILTS | 5 | 10 | 50 | \$ 6,250.00 |
| COM REVIEW COMMENTS | 1 | 10 | 10 | \$ 1,250.00 |
| REVISIONS | 1 | 10 | 10 | \$ 1,250.00 |
| SUBTOTAL | | | 106 | \$ 13,250.00 |
| TAX (HI G.E. TAX (4.166%)) | | | | \$ 552.00 |
| TOTAL | | | | \$ 13,802.00 |
| Totals | | | | |
| SUBTOTAL | | | 476 | \$ 67,937.50 |
| TAX (HI G.E. TAX (4.166%)) | | | | \$ 2,830.28 |
| TOTAL | | | | \$ 70,767.78 |

UHMC DORM REPLACEMENT-RECREATIONAL CENTER

M19011

\$ 125.00

| Task | Day | Hours | Hours | Fee |
|--|-----|-------|------------|---------------------|
| Pre-Design | | | | |
| <i>NOTE: INCLUDED W/ NEW DORM BLDG</i> | | | | |
| CORRESPONDANCE/MEETINGS | 0 | 0 | 0 | \$ - |
| REVIEW/STUDY DESIGN DOCUMENTS | 0 | 0 | 0 | \$ - |
| REVIEW/STUDY GEOTECHNCIAL REPORT | 0 | 0 | 0 | \$ - |
| SUBTOTAL | | | 0 | \$ - |
| TAX (HI G.E. TAX (4.166%)) | | | | \$ - |
| TOTAL | | | | \$ - |
| Structural Analysis | | | | |
| GRAVITY LOADS | 1 | 1 | 1 | \$ 125.00 |
| WIND | 1 | 1 | 1 | \$ 125.00 |
| SEISMIC | 1 | 1 | 1 | \$ 125.00 |
| GRAVITY FORCE RESISTING SYSTEM | 1 | 8 | 8 | \$ 1,000.00 |
| UPLIFT FORCE RESISTING SYSTEM | 1 | 6 | 6 | \$ 750.00 |
| LATERAL FORCE RESISTING SYSTEM | 1 | 8 | 8 | \$ 1,000.00 |
| FOUNDATION DESIGN | 1 | 8 | 8 | \$ 1,000.00 |
| SUBTOTAL | | | 33 | \$ 4,125.00 |
| TAX (HI G.E. TAX (4.166%)) | | | | \$ 171.85 |
| TOTAL | | | | \$ 4,296.85 |
| Plans and Specifications | | | | |
| CONVERSION OF CONSUTANT DRAWINGS | 1 | 6 | 6 | \$ 750.00 |
| ROOF PLAN | 2 | 8 | 16 | \$ 2,000.00 |
| FOUNDATION PLAN | 1 | 8 | 8 | \$ 1,000.00 |
| GENERAL NOTES | 1 | 2 | 2 | \$ 250.00 |
| TYPICAL DETAILS | 1 | 4 | 4 | \$ 500.00 |
| FOUNDATION DETAILS | 1 | 4 | 4 | \$ 500.00 |
| ROOF DETAILS | 1 | 8 | 8 | \$ 1,000.00 |
| MISCELLANEOUS DETAILS | 1 | 6 | 6 | \$ 750.00 |
| SPECIFICATIONS | 1 | 1 | 1 | \$ 125.00 |
| COORDINATION WITH OTHER CONSULTANTS | 1 | 4 | 4 | \$ 500.00 |
| COM REVIEW COMMENTS | 1 | 6 | 6 | \$ 750.00 |
| REVISIONS TO DRAWINGS | 1 | 6 | 6 | \$ 750.00 |
| REVISIONS TO SPECIFICATIONS | 1 | 1 | 1 | \$ 125.00 |
| QA/QC - FINAL COORDINATION | 1 | 6 | 6 | \$ 750.00 |
| PERMIT SUBMITTAL | 1 | 2 | 2 | \$ 250.00 |
| SUBTOTAL | | | 80 | \$ 10,000.00 |
| TAX (HI G.E. TAX (4.166%)) | | | | \$ 416.60 |
| TOTAL | | | | \$ 10,416.60 |
| Permitting | | | | |
| CORRESPONDANCE/MEETINGS | 1 | 5 | 5 | \$ 625.00 |
| REVISIONS TO DRAWINGS | 1 | 8 | 8 | \$ 1,000.00 |
| RESPONSES TO RFIs | 1 | 8 | 8 | \$ 1,000.00 |
| REVISIONS TO SPECIFICATIONS | 1 | 1 | 1 | \$ 125.00 |
| SUBTOTAL | | | 22 | \$ 2,750.00 |
| TAX (HI G.E. TAX (4.166%)) | | | | \$ 114.57 |
| TOTAL | | | | \$ 2,864.57 |
| Construction Administration | | | | |
| SITE VISITS / OBSERVATION | 3 | 3 | 9 | \$ 1,125.00 |
| SUBMITTAL REVIEWS | 1 | 3 | 3 | \$ 375.00 |
| RESPONSES TO RFIs | 1 | 5 | 5 | \$ 625.00 |
| AS BUILTS | 2 | 6 | 12 | \$ 1,500.00 |
| COM REVIEW COMMENTS | 1 | 6 | 6 | \$ 750.00 |
| REVISIONS | 1 | 6 | 6 | \$ 750.00 |
| SUBTOTAL | | | 29 | \$ 3,625.00 |
| TAX (HI G.E. TAX (4.166%)) | | | | \$ 151.02 |
| TOTAL | | | | \$ 3,776.02 |
| Totals | | | | |
| SUBTOTAL | | | 164 | \$ 20,500.00 |
| TAX (HI G.E. TAX (4.166%)) | | | | \$ 854.03 |
| TOTAL | | | | \$ 21,354.03 |

UHMC DORM RENOVATION

M19011

\$ 150.00

| Task | Day | Hours | Hours | Fee |
|--|-----|-------|------------|---------------------|
| Preliminary | | | | |
| CORRESPONDANCE/MEETINGS | 1 | 6 | 6 | \$ 900.00 |
| REVIEW/STUDY DESIGN DOCUMENTS | 2 | 8 | 16 | \$ 2,400.00 |
| REVIEW/STUDY GEOTECHNCIAL REPORT | 1 | 4 | 4 | \$ 600.00 |
| SUBTOTAL | | | 26 | \$ 3,900.00 |
| TAX (HI G.E. TAX (4.166%)) | | | | \$ 162.47 |
| TOTAL | | | | \$ 4,062.47 |
| Structural Analysis | | | | |
| GRAVITY LOADS | 1 | 2 | 2 | \$ 300.00 |
| WIND | 1 | 2 | 2 | \$ 300.00 |
| SEISMIC | 1 | 2 | 2 | \$ 300.00 |
| UPLIFT FORCE RESISTING SYSTEM | 1 | 10 | 10 | \$ 1,500.00 |
| LATERAL FORCE RESISTING SYSTEM | 4 | 10 | 40 | \$ 6,000.00 |
| DESIGN OF NEW MEMBERS AND CONNECTIONS | 4 | 8 | 32 | \$ 4,800.00 |
| SUBTOTAL | | | 88 | \$ 13,200.00 |
| TAX (HI G.E. TAX (4.166%)) | | | | \$ 549.91 |
| TOTAL | | | | \$ 13,749.91 |
| Retrofit Plans and Specifications | | | | |
| EXISTING/DAMAGE PLANS | 5 | 10 | 50 | \$ 7,500.00 |
| REPAIR DRAWINGS | 5 | 10 | 50 | \$ 7,500.00 |
| SPECIFICATIONS | 3 | 8 | 24 | \$ 3,600.00 |
| REVISIONS | 1 | 10 | 10 | \$ 1,500.00 |
| MEETINGS | 1 | 6 | 6 | \$ 900.00 |
| SUBTOTAL | | | 140 | \$ 15,000.00 |
| TAX (HI G.E. TAX (4.166%)) | | | | \$ 624.90 |
| TOTAL | | | | \$ 15,624.90 |
| Permitting | | | | |
| MEETINGS | 1 | 6 | 6 | \$ 900.00 |
| REVISIONS TO DRAWINGS | 1 | 6 | 6 | \$ 900.00 |
| RESPONSES TO RFIs | 1 | 6 | 6 | \$ 900.00 |
| REVISIONS TO SPECIFICATIONS | 1 | 6 | 6 | \$ 900.00 |
| SUBTOTAL | | | 24 | \$ 3,600.00 |
| TAX (HI G.E. TAX (4.166%)) | | | | \$ 149.98 |
| TOTAL | | | | \$ 3,749.98 |
| Construction Administration | | | | |
| SITE VISITS / OBSERVATION | 10 | 3 | 30 | \$ 4,500.00 |
| SUBMITTAL REVIEWS | 1 | 10 | 10 | \$ 1,500.00 |
| RESPONSES TO RFIs | 1 | 10 | 10 | \$ 1,500.00 |
| AS BUILTS | 5 | 8 | 40 | \$ 6,000.00 |
| SUBTOTAL | | | 90 | \$ 13,500.00 |
| TAX (HI G.E. TAX (4.166%)) | | | | \$ 562.41 |
| TOTAL | | | | \$ 14,062.41 |
| Totals | | | | |
| SUBTOTAL | | | 368 | \$ 49,200.00 |
| TAX (HI G.E. TAX (4.166%)) | | | | \$ 2,049.67 |
| TOTAL | | | | \$ 51,249.67 |

UHMC DORM REPLACEMENT-NEW DORM BUILDING

M19011

\$ 125.00

| Task | Day | Hours | Hours | Fee |
|--|-----|-------|------------|---------------------|
| Pre-Design | | | | |
| CORRESPONDANCE/MEETINGS | 1 | 6 | 6 | \$ 750.00 |
| REVIEW/STUDY DESIGN DOCUMENTS | 2 | 8 | 16 | \$ 2,000.00 |
| REVIEW/STUDY GEOTECHNCIAL REPORT | 1 | 4 | 4 | \$ 500.00 |
| SUBTOTAL | | | 26 | \$ 3,250.00 |
| TAX (HI G.E. TAX (4.166%)) | | | | \$ 135.40 |
| TOTAL | | | | \$ 3,385.40 |
| Structural Analysis | | | | |
| GRAVITY LOADS | 1 | 2 | 2 | \$ 250.00 |
| WIND | 1 | 2 | 2 | \$ 250.00 |
| SEISMIC | 1 | 2 | 2 | \$ 250.00 |
| GRAVITY FORCE RESISTING SYSTEM | 2 | 8 | 16 | \$ 2,000.00 |
| UPLIFT FORCE RESISTING SYSTEM | 1 | 6 | 6 | \$ 750.00 |
| LATERAL FORCE REISITING SYSTEM | 3 | 8 | 24 | \$ 3,000.00 |
| FOUNDATION DESIGN | 1 | 8 | 8 | \$ 1,000.00 |
| SUBTOTAL | | | 60 | \$ 7,500.00 |
| TAX (HI G.E. TAX (4.166%)) | | | | \$ 312.45 |
| TOTAL | | | | \$ 7,812.45 |
| Plans and Specifications | | | | |
| CONVERSION OF CONSULTANT DRAWINGS | 1 | 10 | 10 | \$ 1,250.00 |
| ROOF PLAN | 2 | 8 | 16 | \$ 2,000.00 |
| FLOOR PLAN | 2 | 8 | 16 | \$ 2,000.00 |
| FOUNDATION PLAN | 2 | 8 | 16 | \$ 2,000.00 |
| GENERAL NOTES | 1 | 6 | 6 | \$ 750.00 |
| TYPICAL DETAILS | 2 | 8 | 16 | \$ 2,000.00 |
| FOUNDATION DETAILS | 1 | 8 | 8 | \$ 1,000.00 |
| FLOOR DETAILS | 2 | 8 | 16 | \$ 2,000.00 |
| ROOF DETAILS | 2 | 8 | 16 | \$ 2,000.00 |
| MISCELLANEOUS DETAILS | 2 | 8 | 16 | \$ 2,000.00 |
| SPECIFICATIONS | 3 | 8 | 24 | \$ 3,000.00 |
| COORDINATION WITH OTHER CONSULTANTS | 2 | 8 | 16 | \$ 2,000.00 |
| COM REVIEW COMMENTS | 1 | 6 | 6 | \$ 750.00 |
| REVISIONS TO DRAWINGS | 1 | 8 | 8 | \$ 1,000.00 |
| REVISIONS TO SPECIFICATIONS | 1 | 8 | 8 | \$ 1,000.00 |
| QA/QC - FINAL COORDINATION | 1 | 8 | 8 | \$ 1,000.00 |
| PERMIT SUBMITTAL | 1 | 4 | 4 | \$ 500.00 |
| SUBTOTAL | | | 210 | \$ 26,250.00 |
| TAX (HI G.E. TAX (4.166%)) | | | | \$ 1,093.58 |
| TOTAL | | | | \$ 27,343.58 |
| Re-use of Drawings | | | | |
| REUSE FACTOR (2 DORM BUILDINGS, 3 TOTAL) | | | | 0.25 |
| SUBTOTAL | | | | \$ 8,437.50 |
| TAX (HI G.E. TAX (4.166%)) | | | | \$ 351.51 |
| TOTAL | | | | \$ 8,789.01 |
| Permitting | | | | |
| CORRESPONDANCE/MEETINGS | 1 | 10 | 10 | \$ 1,250.00 |
| REVISIONS TO DRAWINGS | 3 | 8 | 24 | \$ 3,000.00 |
| RESPONSES TO RFIs | 2 | 8 | 16 | \$ 2,000.00 |
| REVISIONS TO SPECIFICATIONS | 3 | 8 | 24 | \$ 3,000.00 |
| SUBTOTAL | | | 74 | \$ 9,250.00 |
| TAX (HI G.E. TAX (4.166%)) | | | | \$ 385.36 |
| TOTAL | | | | \$ 9,635.36 |
| Construction Administration | | | | |
| SITE VISITS / OBSERVATION | 12 | 3 | 36 | \$ 4,500.00 |
| SUBMITTAL REVIEWS | 1 | 10 | 10 | \$ 1,250.00 |
| RESPONSES TO RFIs | 1 | 10 | 10 | \$ 1,250.00 |
| AS BUILTS | 5 | 10 | 50 | \$ 6,250.00 |
| COM REVIEW COMMENTS | 1 | 10 | 10 | \$ 1,250.00 |
| REVISIONS | 1 | 10 | 10 | \$ 1,250.00 |
| SUBTOTAL | | | 106 | \$ 13,250.00 |
| TAX (HI G.E. TAX (4.166%)) | | | | \$ 552.00 |
| TOTAL | | | | \$ 13,802.00 |
| Totals | | | | |
| SUBTOTAL | | | 476 | \$ 67,937.50 |
| TAX (HI G.E. TAX (4.166%)) | | | | \$ 2,830.28 |
| TOTAL | | | | \$ 70,767.78 |

UHMC DORM REPLACEMENT-RECREATIONAL CENTER

M19011

\$ 125.00

| Task | Day | Hours | Hours | Fee |
|--|-----|-------|------------|---------------------|
| Pre-Design | | | | |
| <i>NOTE: INCLUDED W/ NEW DORM BLDG</i> | | | | |
| CORRESPONDANCE/MEETINGS | 0 | 0 | 0 | \$ - |
| REVIEW/STUDY DESIGN DOCUMENTS | 0 | 0 | 0 | \$ - |
| REVIEW/STUDY GEOTECHNCIAL REPORT | 0 | 0 | 0 | \$ - |
| SUBTOTAL | | | 0 | \$ - |
| TAX (HI G.E. TAX (4.166%)) | | | | \$ - |
| TOTAL | | | | \$ - |
| Structural Analysis | | | | |
| GRAVITY LOADS | 1 | 1 | 1 | \$ 125.00 |
| WIND | 1 | 1 | 1 | \$ 125.00 |
| SEISMIC | 1 | 1 | 1 | \$ 125.00 |
| GRAVITY FORCE RESISTING SYSTEM | 1 | 8 | 8 | \$ 1,000.00 |
| UPLIFT FORCE RESISTING SYSTEM | 1 | 6 | 6 | \$ 750.00 |
| LATERAL FORCE RESISTING SYSTEM | 1 | 8 | 8 | \$ 1,000.00 |
| FOUNDATION DESIGN | 1 | 8 | 8 | \$ 1,000.00 |
| SUBTOTAL | | | 33 | \$ 4,125.00 |
| TAX (HI G.E. TAX (4.166%)) | | | | \$ 171.85 |
| TOTAL | | | | \$ 4,296.85 |
| Plans and Specifications | | | | |
| CONVERSION OF CONSUTANT DRAWINGS | 1 | 6 | 6 | \$ 750.00 |
| ROOF PLAN | 2 | 8 | 16 | \$ 2,000.00 |
| FOUNDATION PLAN | 1 | 8 | 8 | \$ 1,000.00 |
| GENERAL NOTES | 1 | 2 | 2 | \$ 250.00 |
| TYPICAL DETAILS | 1 | 4 | 4 | \$ 500.00 |
| FOUNDATION DETAILS | 1 | 4 | 4 | \$ 500.00 |
| ROOF DETAILS | 1 | 8 | 8 | \$ 1,000.00 |
| MISCELLANEOUS DETAILS | 1 | 6 | 6 | \$ 750.00 |
| SPECIFICATIONS | 1 | 1 | 1 | \$ 125.00 |
| COORDINATION WITH OTHER CONSULTANTS | 1 | 4 | 4 | \$ 500.00 |
| COM REVIEW COMMENTS | 1 | 6 | 6 | \$ 750.00 |
| REVISIONS TO DRAWINGS | 1 | 6 | 6 | \$ 750.00 |
| REVISIONS TO SPECIFICATIONS | 1 | 1 | 1 | \$ 125.00 |
| QA/QC - FINAL COORDINATION | 1 | 6 | 6 | \$ 750.00 |
| PERMIT SUBMITTAL | 1 | 2 | 2 | \$ 250.00 |
| SUBTOTAL | | | 80 | \$ 10,000.00 |
| TAX (HI G.E. TAX (4.166%)) | | | | \$ 416.60 |
| TOTAL | | | | \$ 10,416.60 |
| Permitting | | | | |
| CORRESPONDANCE/MEETINGS | 1 | 5 | 5 | \$ 625.00 |
| REVISIONS TO DRAWINGS | 1 | 8 | 8 | \$ 1,000.00 |
| RESPONSES TO RFIs | 1 | 8 | 8 | \$ 1,000.00 |
| REVISIONS TO SPECIFICATIONS | 1 | 1 | 1 | \$ 125.00 |
| SUBTOTAL | | | 22 | \$ 2,750.00 |
| TAX (HI G.E. TAX (4.166%)) | | | | \$ 114.57 |
| TOTAL | | | | \$ 2,864.57 |
| Construction Administration | | | | |
| SITE VISITS / OBSERVATION | 3 | 3 | 9 | \$ 1,125.00 |
| SUBMITTAL REVIEWS | 1 | 3 | 3 | \$ 375.00 |
| RESPONSES TO RFIs | 1 | 5 | 5 | \$ 625.00 |
| AS BUILTS | 2 | 6 | 12 | \$ 1,500.00 |
| COM REVIEW COMMENTS | 1 | 6 | 6 | \$ 750.00 |
| REVISIONS | 1 | 6 | 6 | \$ 750.00 |
| SUBTOTAL | | | 29 | \$ 3,625.00 |
| TAX (HI G.E. TAX (4.166%)) | | | | \$ 151.02 |
| TOTAL | | | | \$ 3,776.02 |
| Totals | | | | |
| SUBTOTAL | | | 164 | \$ 20,500.00 |
| TAX (HI G.E. TAX (4.166%)) | | | | \$ 854.03 |
| TOTAL | | | | \$ 21,354.03 |

APPENDIX 'B'

OPTION 1

Project Name: 820 Ka'ahumanu Ave, Bldg 2248A, 2248B, 2248C & 2248D Restoration

November 18, 2019

Date of Bid: 11/18/19

Schedule:

6 months

Prevailing Wages

| | Quan | Unit | Labor | Material | Subcontractor | Other | TOTAL | Notes |
|--|--------|------|---------|----------|---------------|--------|---------|-------|
| DIVISION 6 | | | | | | | - | |
| Rough Carpentry | | | | | | | - | |
| Building structural repairs | 640 | mhrs | 57,600 | 15,000 | | | 72,600 | |
| Exterior siding over waterproofing membrane, exterior trim | 18,282 | sf | 68,558 | 41,135 | | | 109,692 | |
| Scaffolding | 4 | mo | | | | 20,000 | 20,000 | |
| Finish Carpentry | | | | | | | - | |
| Finish carpentry in units | 960 | mhrs | 86,400 | | | | 86,400 | |
| 1x4 wood base | 3,082 | lf | | 3,082 | | | 3,082 | |
| 1x3 Door casing | 3,168 | lf | | 3,010 | | | 3,010 | |
| 1x3 window casing | 2,592 | lf | | 2,462 | | | 2,462 | |
| Kitchen base cabinets | 144 | lf | | 21,600 | | | 21,600 | |
| Kitchen upper cabinets | 84 | lf | | 6,300 | | | 6,300 | |
| Kitchen Countertops - P-lam | 144 | lf | | 10,800 | | | 10,800 | |
| Bath vanity | 60 | lf | | 9,000 | | | 9,000 | |
| Vanity countertops - P-lam | 60 | lf | | 4,500 | | | 4,500 | |
| Closet shelving | 36 | lf | | 360 | | | 360 | |
| Misc fasteners and shims | | | | 1,800 | | | 1,800 | |
| Finish carpentry in community building | 160 | mhrs | 14,400 | | | | 14,400 | |
| 1x4 wood base | 386 | lf | | 386 | | | 386 | |
| 1x3 Door casing | 576 | lf | | 547 | | | 547 | |
| 1x3 window casing | 216 | lf | | 205 | | | 205 | |
| Base cabinets | 12 | lf | | 1,800 | | | 1,800 | |
| Upper cabinets | 12 | lf | | 900 | | | 900 | |
| Countertops | 12 | lf | | 900 | | | 900 | |
| Shelving | 1 | ls | | 250 | | | 250 | |
| Misc fasteners and shims | | | | 250 | | | 250 | |
| | | | | | | | - | |
| DIVISION 7 | | | | | | | - | |
| Building Insulation - Roof | 15,635 | sf | 31,270 | 22,670 | | | 53,940 | |
| Building insulation - floor | 5,550 | sf | 11,100 | 8,048 | | | 19,148 | |
| Building insulation - walls | 20,952 | sf | 20,952 | 13,619 | | | 34,571 | |
| Roofing | 15,635 | sf | | | 125,078 | | 125,078 | |
| Gutters and downspouts | 1 | ls | | | 76,425 | | 76,425 | |
| Joint Sealers | 1 | ls | | | 3,500 | | 3,500 | |
| | | | | | | | - | |
| DIVISION 8 | | | | | | | - | |
| Exterior doors | 29 | ea | 13,050 | 14,500 | | | 27,550 | |
| Interior doors | 53 | ea | 18,550 | 13,250 | | | 31,800 | |
| Sliding Glass Doors | 5 | ea | 2,250 | 4,250 | | | 6,500 | |
| Glass window | 2 | ea | 900 | 1,700 | | | 2,600 | |
| Vinyl windows | 115 | ea | 20,700 | 34,500 | | | 55,200 | |
| Door hardware | 82 | ea | 7,380 | 21,730 | | | 29,110 | |
| Mirrors at Bathrooms at Units | 192 | sf | 2,880 | 2,112 | | | 4,992 | |
| | | | | | | | - | |
| | | | | | | | - | |
| DIVISION 9 | | | | | | | - | |
| Gypsum board | 45,771 | sf | 137,313 | 45,771 | | | 183,084 | |
| Carpet in units | 7,140 | sf | | | 42,840 | | 42,840 | |
| Vinyl in units | 2,160 | sf | | | 10,800 | | 10,800 | |
| Tile in Comm Center | 1 | ls | | | 37,440 | | 37,440 | |
| LVT in comm center | 1,044 | sf | | | 9,396 | | 9,396 | |
| Interior painting | 1 | ls | | | 91,203 | | 91,203 | |

| | | | | | | | | | |
|---|--|------|------|-----------|----------|---------------|--------|-------------------|------------------|
| Project Name: 820 Ka'ahumanu Ave, Bldg 2248A, 2248B, 2248C & 2248D Restoration | | | | | | | | November 18, 2019 | |
| Date of Bid: 11/18/19 | | | | Schedule: | | 6 months | | | |
| Prevailing Wages | | | | | | | | | |
| | | Quan | Unit | Labor | Material | Subcontractor | Other | TOTAL | Notes |
| Exterior painting | | 1 | ls | | | 95,981 | | 95,981 | |
| | | | | | | | | - | |
| DIVISION 10 | | 0 | | | | | | - | |
| Toilet accessories | | 64 | mhrs | 5,760 | 6,300 | | | 12,060 | |
| Toilet partitions in Comm center | | 48 | mhrs | 4,320 | 4,500 | | | 8,820 | |
| Door signage | | 25 | ea | 1,000 | 3,750 | | | 4,750 | |
| Fire extinguishers | | 14 | ea | 1,260 | 1,610 | | | 2,870 | |
| | | | | | | | | - | |
| DIVISION 11 | | | | | | | | - | |
| Comm Center laundry equipment | | | | | | | | - | by Owner |
| 30" Slide in Range | | 12 | ea | 2,160 | 4,320 | | | 6,480 | |
| 30" Non Vented Micro Wave | | 12 | ea | 2,160 | 3,240 | | | 5,400 | |
| 18 CF Fridge | | 12 | ea | 2,160 | 7,020 | | | 9,180 | |
| | | | | | | | | - | |
| DIVISION 15 | | | | | | | | - | |
| Plumbing | | 1 | ls | | | 247,551 | | 247,551 | |
| HVAC | | 1 | ls | | | 27,200 | | 27,200 | |
| Fire Sprinklers | | 1 | ls | | | 139,087 | | 139,087 | |
| | | | | | | | | - | |
| DIVISION 16 | | | | | | | | - | |
| Electrical | | 1 | ls | | | 225,000 | | 225,000 | |
| Fire Alarm | | 1 | ls | | | 85,000 | | 85,000 | |
| Phone lines | | 1 | ls | | | 18,000 | | 18,000 | |
| | | | | | | | | - | |
| TOTAL JOB COST | | | | 660,620 | 391,569 | 1,630,528 | 49,700 | 2,732,416.66 | 2,732,417 |
| | | | | | | | | | - |
| Contingency @ | | | | | | | | 10% | 273,242 |
| | | | | | | | | | |
| Liability Insurance | | | | | | | | | |
| Labor | | | | | | | | 2.4% | 15,855 |
| Subcontractors | | | | | | | | 0.3% | 4,076 |
| TOTAL JOB COSTS WITH INS | | | | | | | | | 3,025,590 |
| | | | | | | | | | |
| PROFIT AND OVERHEAD @ | | | | | | | | 15.00% | 453,838 |
| Subtotal | | | | | | | | | 3,479,428 |
| | | | | | | | | | |
| GET | | | | | | | | | 144,976 |
| | | | | | | | | | |
| SUBTOTAL CONTRACT VALUE | | | | | | | | | 3,624,404 |
| | | | | | | | | | |
| Bond | | | | | | | | | 72,488 |
| | | | | | | | | | |
| Total Project Sell Price | | | | | | | | | 3,696,892 |

OPTION 2

| | | | | | | | | | |
|---|------|------|-------|-----------|---------------|----------|--|-------------------|-------|
| Project Name: 820 Ka'ahumanu Ave, Bldg 2248A, 2248B, 2248C & 2248D Restoration | | | | | | | | November 18, 2019 | |
| Date of Bid: 11/18/19 | | | | Schedule: | | 9 months | | | |
| Prevailing Wages | | | | | | | | | |
| | Quan | Unit | Labor | Material | Subcontractor | Other | | TOTAL | Notes |
| DIVISION 6 | | | | | | | | - | |
| Rough Carpentry | | | | | | | | - | |
| Frame buildings (includes walls trusses, roof sheathing, fascia, all hardware) | | | | | | | | 781,740 | |
| Exterior siding over waterproofing membrane, exterior trim | | | | | | | | 109,692 | |
| Scaffolding | | | | | | | | 35,000 | |
| Finish Carpentry | | | | | | | | - | |
| Finish carpentry in units | | | | | | | | 86,400 | |
| 1x4 wood base | | | | | | | | 3,082 | |
| 1x3 Door casing | | | | | | | | 3,010 | |
| 1x3 window casing | | | | | | | | 2,462 | |
| Kitchen base cabinets | | | | | | | | 21,600 | |
| Kitchen upper cabinets | | | | | | | | 6,300 | |
| Kitchen Countertops - P-lam | | | | | | | | 10,800 | |
| Bath vanity | | | | | | | | 9,000 | |
| Vanity countertops - P-lam | | | | | | | | 4,500 | |
| Closet shelving | | | | | | | | 360 | |
| Misc fasteners and shims | | | | | | | | 1,800 | |
| Finish carpentry in community building | | | | | | | | 14,400 | |
| 1x4 wood base | | | | | | | | 386 | |
| 1x3 Door casing | | | | | | | | 547 | |
| 1x3 window casing | | | | | | | | 205 | |
| Base cabinets | | | | | | | | 1,800 | |
| Upper cabinets | | | | | | | | 900 | |
| Countertops | | | | | | | | 900 | |
| Shelving | | | | | | | | 250 | |
| Misc fasteners and shims | | | | | | | | 250 | |
| | | | | | | | | - | |
| DIVISION 7 | | | | | | | | - | |
| Building Insulation - Roof | | | | | | | | 53,940 | |
| Building insulation - floor | | | | | | | | 19,148 | |
| Building insulation - walls | | | | | | | | 34,571 | |
| Roofing | | | | | | | | 125,078 | |
| Gutters and downspouts | | | | | | | | 76,425 | |
| Joint Sealers | | | | | | | | 3,500 | |
| | | | | | | | | - | |
| DIVISION 8 | | | | | | | | | |
| Exterior doors | | | | | | | | 27,550 | |
| Interior doors | | | | | | | | 31,800 | |
| Sliding Glass Doors | | | | | | | | 6,500 | |
| Glass window | | | | | | | | 2,600 | |
| Vinyl windows | | | | | | | | 55,200 | |
| Door hardware | | | | | | | | 29,110 | |
| Mirrors at Bathrooms at Units | | | | | | | | 4,992 | |
| | | | | | | | | - | |
| | | | | | | | | - | |
| DIVISION 9 | | | | | | | | | |
| Gypsum board | | | | | | | | 183,084 | |
| Carpet in units | | | | | | | | 42,840 | |
| Vinyl in units | | | | | | | | 10,800 | |
| Tile in Comm Center | | | | | | | | 37,440 | |
| LVT in comm center | | | | | | | | 9,396 | |

| | | | | | | | | | |
|---|------|------|-----------|-----------|---------------|----------|--------------|-------------------|----------|
| Project Name: 820 Ka'ahumanu Ave, Bldg 2248A, 2248B, 2248C & 2248D Restoration | | | | | | | | November 18, 2019 | |
| Date of Bid: 11/18/19 | | | | Schedule: | | 9 months | | | |
| Prevailing Wages | | | | | | | | | |
| | Quan | Unit | Labor | Material | Subcontractor | Other | | TOTAL | Notes |
| Interior painting | 1 | ls | | | 91,203 | | | 91,203 | |
| Exterior painting | 1 | ls | | | 95,981 | | | 95,981 | |
| | | | | | | | | - | |
| DIVISION 10 | 0 | | | | | | | - | |
| Toilet accessories | 64 | mhrs | 5,760 | 6,300 | | | | 12,060 | |
| Toilet partitions in Comm center | 48 | mhrs | 4,320 | 4,500 | | | | 8,820 | |
| Door signage | 25 | ea | 1,000 | 3,750 | | | | 4,750 | |
| Fire extinguishers | 14 | ea | 1,260 | 1,610 | | | | 2,870 | |
| | | | | | | | | - | |
| DIVISION 11 | | | | | | | | - | |
| Comm Center laundry equipment | | | | | | | | - | by Owner |
| 30" Slide in Range | 12 | ea | 2,160 | 4,320 | | | | 6,480 | |
| 30" Non Vented Micro Wave | 12 | ea | 2,160 | 3,240 | | | | 5,400 | |
| 18 CF Fridge | 12 | ea | 2,160 | 7,020 | | | | 9,180 | |
| | | | | | | | | - | |
| DIVISION 15 | | | | | | | | - | |
| Plumbing | 1 | ls | | | 325,725 | | | 325,725 | |
| HVAC | 1 | ls | | | 27,200 | | | 27,200 | |
| Fire Sprinklers | 1 | ls | | | 159,087 | | | 159,087 | |
| | | | | | | | | - | |
| DIVISION 16 | | | | | | | | - | |
| Electrical | 1 | ls | | | 325,000 | | | 325,000 | |
| Fire Alarm | 1 | ls | | | 85,000 | | | 85,000 | |
| Phone lines | 1 | ls | | | 18,000 | | | 18,000 | |
| | | | | | | | | - | |
| TOTAL JOB COST | | | 1,126,735 | 716,574 | 1,908,702 | 60,150 | 3,812,160.66 | 3,812,161 | - |
| Contingency @ | | | | | | | 10% | 381,216 | |
| Liability Insurance | | | | | | | | | |
| Labor | | | | | | | 2.4% | 27,042 | |
| Subcontractors | | | | | | | 0.3% | 4,772 | |
| TOTAL JOB COSTS WITH INS | | | | | | | | 4,225,190 | |
| PROFIT AND OVERHEAD @ | | | | | | | 15.00% | 633,779 | |
| Subtotal | | | | | | | | 4,858,969 | |
| GET | | | | | | | | 202,457 | |
| SUBTOTAL CONTRACT VALUE | | | | | | | | 5,061,426 | |
| Bond | | | | | | | | 101,229 | |
| Total Project Sell Price | | | | | | | | 5,162,654 | |

OPTION 3

Project Name: 820 Ka'ahumanu Ave, Bldg 2248A, 2248B, 2248C & 2248D Restoration

November 18, 2019

Date of Bid: 11/18/19

Schedule:


12 months

Prevailing Wages

| Spec Section | Quan | Unit | Labor | Material | Subcontractor | Other | TOTAL | Notes |
|---|--------|--------|---------|----------|---------------|--------|---------|----------|
| DIVISION 1 | | | | | | | | |
| Building Permits | 1 | ls | | | | - | - | by Owner |
| Plan Check Fee | 1 | ls | | | | - | - | by Owner |
| Supervision | 12.0 | Months | 208,800 | | | | 208,800 | |
| Pickup Truck | 12.0 | Months | | | | 6,600 | 6,600 | |
| Fuel Allowance | 12.0 | Months | | 4,200 | | | 4,200 | |
| Schedules | 1 | ls | | | | 1,200 | 1,200 | |
| Submittals | 1 | ls | 4,500 | | | | 4,500 | |
| Temp Toilets | 12.0 | Months | | 4,320 | | | 4,320 | |
| Jobsite Fence | 1,116 | lf | 3,348 | 2,232 | | | 5,580 | |
| Job Trailer | 12.0 | Months | | 12,000 | | | 12,000 | |
| Cleanup-Continuos | 12.0 | Months | 18,000 | | | | 18,000 | |
| Final Cleaning | 13,029 | sf | | | 6,515 | | 6,515 | |
| As-Builts | 1 | ls | 6,500 | | | | 6,500 | |
| Layout | 1 | ls | 10,000 | | | | 10,000 | |
| Temp. Power Hookup | 1 | ls | | | 2,500 | | 2,500 | |
| Electric Fees | 12.0 | Months | | | | | - | by Owner |
| Office Expenses | 12.0 | Months | | 600 | | | 600 | |
| First Aid Equip/Safety Equipment | 12.0 | Months | | 6,000 | | | 6,000 | |
| Quality Control | 1 | ls | - | | | - | - | by Owner |
| Project Sign | 1 | ea | 450 | 1,200 | | | 1,650 | |
| Dumpsters | 12 | months | | 24,000 | | | 24,000 | |
| Unload Materials/Forklift | 1 | ls | 13,500 | | | 22,500 | 36,000 | |
| Plans/Specs | 4 | sets | | 3,600 | | | 3,600 | |
| Small Tools | 1 | ls | | 6,500 | | | 6,500 | |
| Surveyor | 4 | days | | | 11,200 | | 11,200 | |
| Bee and wasp removal | 1 | ls | | | | 1,500 | 1,500 | |
| Termite treatment | 0 | bldgs | | | | - | - | |
| DIVISION 2 | | | | | | | | |
| Abatement | 1 | ls | | | 56,000 | | 56,000 | |
| Building Exterior Demo (siding, doors, windows, gutters) | 1 | ls | | | 120,000 | | 120,000 | |
| Building Interior Demo (floor/wall/ceiling finishes, cabinetry, electrical and plumbing fixtures) | 13,029 | sf | | | 104,232 | | 104,232 | |
| Concrete slabs and footings removal/disposal | 1 | ls | | | 60,000 | | 60,000 | |
| Regrade and install new sub base for foundations | 1 | ls | | | 85,000 | | 85,000 | |
| Site Clearing and Grubbing | 37,882 | sf | | | 9,471 | | 9,471 | |
| BMPs | 1 | ls | | | 2,500 | | 2,500 | |
| Repave parking lot | 7,245 | sf | | | 57,960 | | 57,960 | |
| Pavement Stripping | 1 | ls | | | 3,500 | | 3,500 | |
| ADA Parkiign Sign | 1 | ea | | | 750 | | 750 | |
| Landscaping Allowance | 1 | ls | | | 65,000 | | 65,000 | |
| DIVISION 3 | | | | | | | | |
| Spall repairs | 1 | ls | | | 25,000 | | 25,000 | |
| New concrete footings and slabs, including rebar reinforcement | 277 | cy | | | 332,400 | | 332,400 | |
| Termite treatment for slabs | 1 | ls | | | 10,000 | | 10,000 | |
| Concrete sidewalks repairs | 80 | mhrs | 7,200 | 1,500 | | | 8,700 | |
| DIVISION 4 | | | | | | | | |
| Trash enclosure | 228 | sf | | | 11,400 | | 11,400 | |
| DIVISION 5 | | | | | | | | |
| Metal handrails at stairs | 4 | ea | 2,880 | 12,800 | | | 15,680 | |
| Trash enclosure gate | 1 | ea | 720 | 2,500 | | | 3,220 | |

| | | | | | | | | | |
|---|--------|------|---------|-----------|---------------|-----------|--|-------------------|-------|
| Project Name: 820 Ka'ahumanu Ave, Bldg 2248A, 2248B, 2248C & 2248D Restoration | | | | | | | | November 18, 2019 | |
| Date of Bid: 11/18/19 | | | | Schedule: | | 12 months | | | |
| Prevailing Wages | | | | | | | | | |
| | Quan | Unit | Labor | Material | Subcontractor | Other | | TOTAL | Notes |
| DIVISION 6 | | | | | | | | - | |
| Rough Carpentry | | | | | | | | - | |
| Frame buildings (includes walls trusses, roof sheathing, fascia, all hardware) | 13,029 | sf | 456,015 | 325,725 | | | | 781,740 | |
| Exterior siding over waterproofing membrane, exterior trim | 18,282 | sf | 68,558 | 41,135 | | | | 109,692 | |
| Scaffolding | 7 | mo | | | | 35,000 | | 35,000 | |
| Finish Carpentry | | | | | | | | - | |
| Finish carpentry in units | 960 | mhrs | 86,400 | | | | | 86,400 | |
| 1x4 wood base | 3,082 | lf | | 3,082 | | | | 3,082 | |
| 1x3 Door casing | 3,168 | lf | | 3,010 | | | | 3,010 | |
| 1x3 window casing | 2,592 | lf | | 2,462 | | | | 2,462 | |
| Kitchen base cabinets | 144 | lf | | 21,600 | | | | 21,600 | |
| Kitchen upper cabinets | 84 | lf | | 6,300 | | | | 6,300 | |
| Kitchen Countertops - P-lam | 144 | lf | | 10,800 | | | | 10,800 | |
| Bath vanity | 60 | lf | | 9,000 | | | | 9,000 | |
| Vanity countertops - P-lam | 60 | lf | | 4,500 | | | | 4,500 | |
| Closet shelving | 36 | lf | | 360 | | | | 360 | |
| Misc fasteners and shims | | | | 1,800 | | | | 1,800 | |
| Finish carpentry in community building | 160 | mhrs | 14,400 | | | | | 14,400 | |
| 1x4 wood base | 386 | lf | | 386 | | | | 386 | |
| 1x3 Door casing | 576 | lf | | 547 | | | | 547 | |
| 1x3 window casing | 216 | lf | | 205 | | | | 205 | |
| Base cabinets | 12 | lf | | 1,800 | | | | 1,800 | |
| Upper cabinets | 12 | lf | | 900 | | | | 900 | |
| Countertops | 12 | lf | | 900 | | | | 900 | |
| Shelving | 1 | ls | | 250 | | | | 250 | |
| Misc fasteners and shims | | | | 250 | | | | 250 | |
| | | | | | | | | - | |
| DIVISION 7 | | | | | | | | - | |
| Building Insulation - Roof | 15,635 | sf | 31,270 | 22,670 | | | | 53,940 | |
| Building insulation - floor | 5,550 | sf | 11,100 | 8,048 | | | | 19,148 | |
| Building insulation - walls | 20,952 | sf | 20,952 | 13,619 | | | | 34,571 | |
| Roofing | 15,635 | sf | | | | 125,078 | | 125,078 | |
| Gutters and downspouts | 1 | ls | | | | 76,425 | | 76,425 | |
| Joint Sealers | 1 | ls | | | | 3,500 | | 3,500 | |
| | | | | | | | | - | |
| DIVISION 8 | | | | | | | | - | |
| Exterior doors | 29 | ea | 13,050 | 14,500 | | | | 27,550 | |
| Interior doors | 53 | ea | 18,550 | 13,250 | | | | 31,800 | |
| Sliding Glass Doors | 5 | ea | 2,250 | 4,250 | | | | 6,500 | |
| Glass window | 2 | ea | 900 | 1,700 | | | | 2,600 | |
| Vinyl windows | 115 | ea | 20,700 | 34,500 | | | | 55,200 | |
| Door hardware | 82 | ea | 7,380 | 21,730 | | | | 29,110 | |
| Mirrors at Bathrooms at Units | 192 | sf | 2,880 | 2,112 | | | | 4,992 | |
| | | | | | | | | - | |
| DIVISION 9 | | | | | | | | - | |
| Gypsum board | 45,771 | sf | 137,313 | 45,771 | | | | 183,084 | |
| Carpet in units | 7,140 | sf | | | 42,840 | | | 42,840 | |
| Vinyl in units | 2,160 | sf | | | 10,800 | | | 10,800 | |
| Tile in Comm Center | 1 | ls | | | 37,440 | | | 37,440 | |
| LVT in comm center | 1,044 | sf | | | 9,396 | | | 9,396 | |
| Interior painting | 1 | ls | | | 91,203 | | | 91,203 | |
| Exterior painting | 1 | ls | | | 95,981 | | | 95,981 | |

| | | | | | | | | | |
|---|------|------|-----------|-----------|---------------|-----------|--------------|-------------------|----------|
| Project Name: 820 Ka'ahumanu Ave, Bldg 2248A, 2248B, 2248C & 2248D Restoration | | | | | | | | November 18, 2019 | |
| Date of Bid: 11/18/19 | | | | Schedule: | | 12 months | | | |
| Prevailing Wages | | | | | | | | | |
| | Quan | Unit | Labor | Material | Subcontractor | Other | | TOTAL | Notes |
| DIVISION 10 | 0 | | | | | | | - | |
| Toilet accessories | 64 | mhrs | 5,760 | 6,300 | | | | 12,060 | |
| Toilet partitions in Comm center | 48 | mhrs | 4,320 | 4,500 | | | | 8,820 | |
| Door signage | 25 | ea | 1,000 | 3,750 | | | | 4,750 | |
| Fire extinguishers | 14 | ea | 1,260 | 1,610 | | | | 2,870 | |
| DIVISION 11 | | | | | | | | - | |
| Comm Center laundry equipment | | | | | | | | - | by Owner |
| 30" Slide in Range | 12 | ea | 2,160 | 4,320 | | | | 6,480 | |
| 30" Non Vented Micro Wave | 12 | ea | 2,160 | 3,240 | | | | 5,400 | |
| 18 CF Fridge | 12 | ea | 2,160 | 7,020 | | | | 9,180 | |
| DIVISION 15 | | | | | | | | - | |
| Plumbing | 1 | ls | | | 456,015 | | | 456,015 | |
| HVAC | 1 | ls | | | 27,200 | | | 27,200 | |
| Fire Sprinklers | 1 | ls | | | 159,087 | | | 159,087 | |
| DIVISION 16 | | | | | | | | - | |
| Electrical | 1 | ls | | | 400,000 | | | 400,000 | |
| Fire Alarm | 1 | ls | | | 85,000 | | | 85,000 | |
| Phone lines | 1 | ls | | | 18,000 | | | 18,000 | |
| TOTAL JOB COST | | | 1,186,435 | 729,354 | 2,601,392 | 66,800 | 4,583,980.66 | 4,583,981 | - |
| Contingency @ | | | | | | | 10% | 458,398 | |
| Liability Insurance | | | | | | | | | |
| Labor | | | | | | | 2.4% | 28,474 | |
| Subcontractors | | | | | | | 0.3% | 6,503 | |
| TOTAL JOB COSTS WITH INS | | | | | | | | 5,077,357 | |
| PROFIT AND OVERHEAD @ | | | | | | | 15.00% | 761,603 | |
| Subtotal | | | | | | | | 5,838,960 | |
| GET | | | | | | | | 243,290 | |
| SUBTOTAL CONTRACT VALUE | | | | | | | | 6,082,250 | |
| Bond | | | | | | | | 121,645 | |
| Total Project Sell Price | | | | | | | | 6,203,895 | |

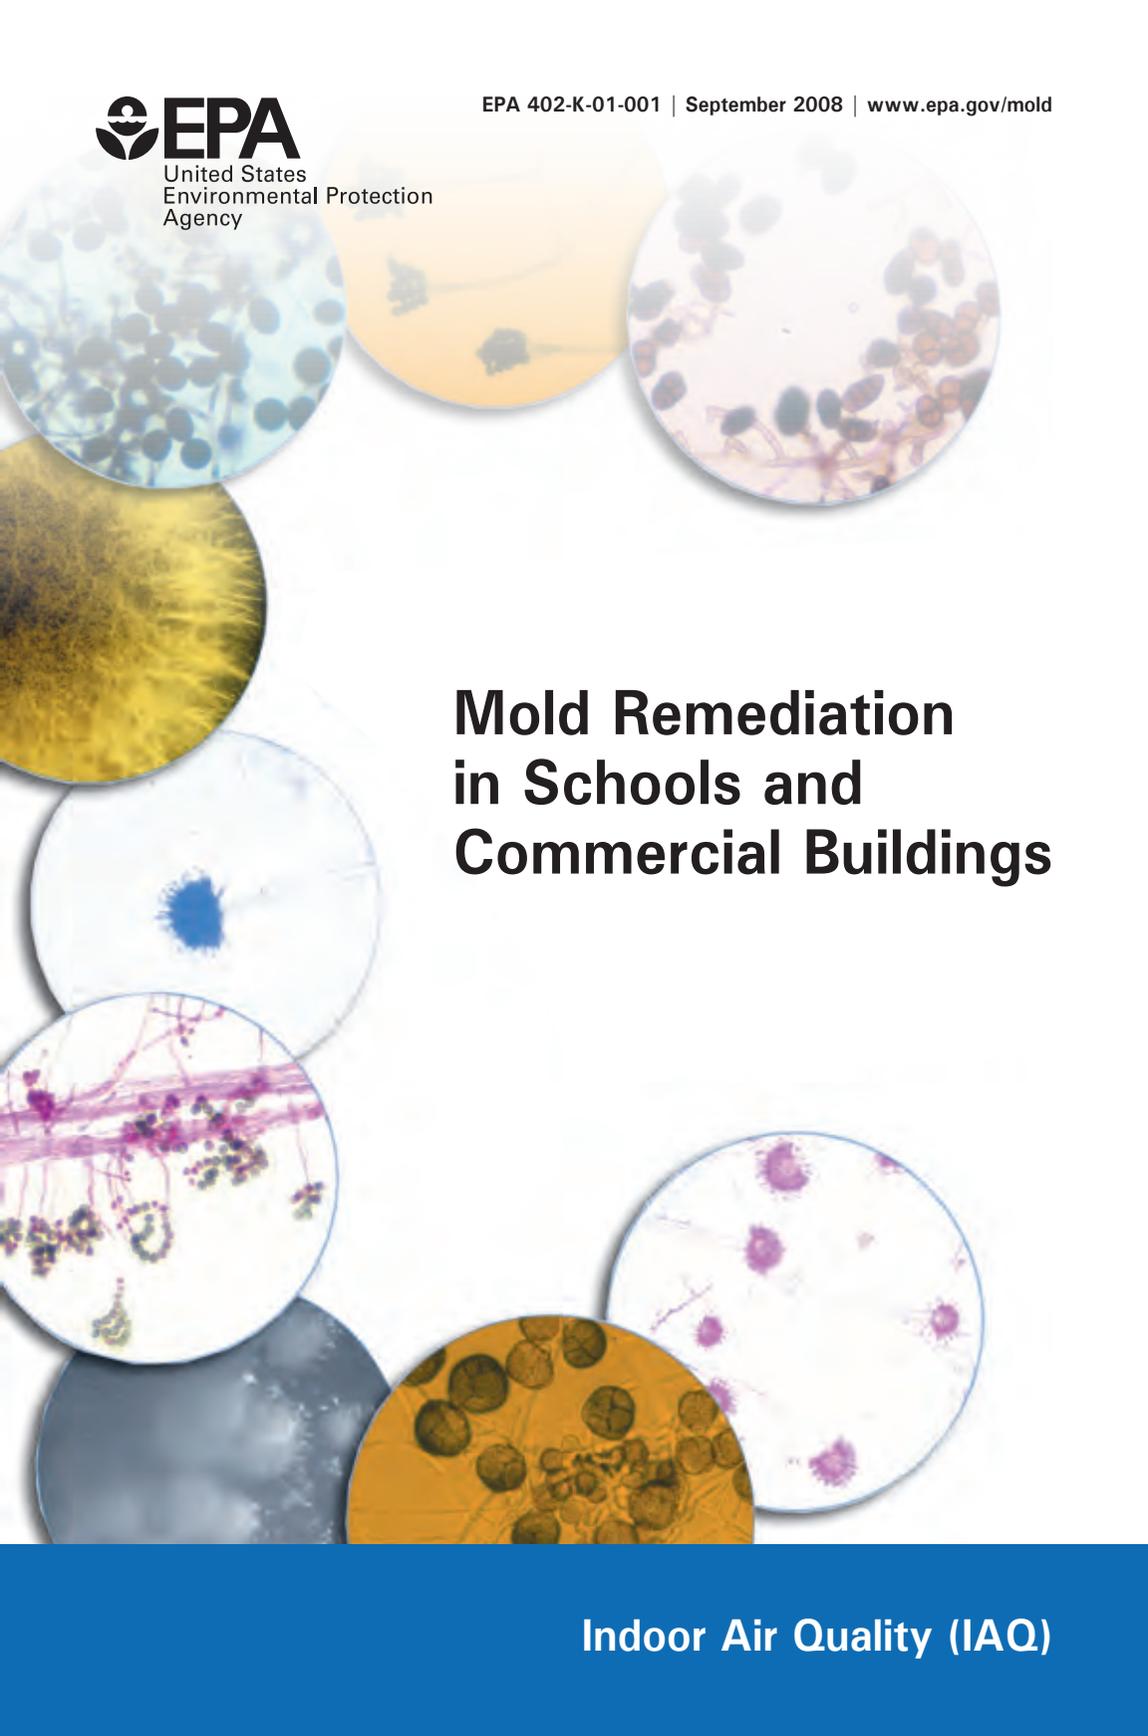

Mold Remediation in Schools and Commercial Buildings

Acknowledgements

This document was prepared by the Indoor Environments Division (IED) of the U.S. Environmental Protection Agency. IED would like to thank the reviewers of this document who provided many valuable and insightful comments, and the contractors who provided support during the development of this document.

EPA would also like to thank those who provided photos: Terry Brennan (Photo #2, Photo #3A, Photo #4A, Photo #6, Photo #8, Photo #9); Paul Ellringer (Photo #4C); Stephen Vesper, Ph.D. (Photo #3B); and Chin Yang, Ph.D. (cover photos, Photo #4B, Photo #5, Photo #7).

Please note that this document presents *recommendations* on mold remediation. EPA does not regulate mold or mold spores in indoor air.

Mold Remediation in Schools and Commercial Buildings

Contents

| | |
|--|-----------|
| INTRODUCTION | 1 |
| PREVENTION | 3 |
| INVESTIGATING, EVALUATING, AND REMEDIATING MOISTURE AND MOLD PROBLEMS | 4 |
| Mold Remediation – Key Steps | 5 |
| Plan the Remediation Before Starting Work | 6 |
| Remediation Plan | 6 |
| HVAC System | 7 |
| Hidden Mold | 8 |
| Remediation | 9 |
| Table 1: Water Damage – Cleanup and Mold Prevention..... | 10 |
| Table 2: Mold Remediation Guidelines..... | 12 |
| Cleanup Methods..... | 16 |
| Personal Protective Equipment (PPE) | 19 |
| Containment | 21 |
| Equipment..... | 23 |
| How Do You Know When You Have Finished Remediation/Cleanup?..... | 26 |
| CHECKLIST FOR MOLD REMEDIATION | 27 |
| RESOURCES LIST | 29 |
| REFERENCES | 35 |
| APPENDIX A – GLOSSARY | 37 |
| APPENDIX B – INTRODUCTION TO MOLDS | 39 |
| Molds in the Environment..... | 39 |
| Health Effects and Symptoms Associated with Mold Exposure..... | 39 |
| Mold Toxins..... | 41 |
| Microbial Volatile Organic Compounds (mVOCs)..... | 43 |
| Glucans or Fungal Cell Wall Components | 43 |
| Spores..... | 43 |
| APPENDIX C – COMMUNICATION WITH BUILDING OCCUPANTS | 45 |
| Mold in Schools | 45 |
| INDEX | 47 |

Introduction

Concern about indoor exposure to mold has been increasing as the public becomes aware that exposure to mold can cause a variety of health effects and symptoms, including allergic reactions. This document presents guidelines for the remediation/cleanup of mold and moisture problems in schools and commercial buildings; these guidelines include measures designed to protect the health of building occupants and remediators. It has been designed primarily for building managers, custodians, and others who are responsible for commercial building and school maintenance. It should serve as a reference for potential mold and moisture remediators. Using this document, individuals with little or no experience with mold remediation should be able to make a reasonable judgment as to whether the situation can be handled in-house. It will help those in charge of maintenance to evaluate an in-house remediation plan or a remediation plan submitted by an outside contractor.¹ Contractors and other professionals who respond to mold and moisture situations in commercial buildings and schools may also want to refer to these guidelines.

Molds gradually destroy the things they grow on. Prevent damage to building materials and furnishings, save money, and avoid potential health risks by controlling moisture and eliminating mold growth.



Photo 2: Extensive mold contamination of ceiling and walls

¹ If you choose to use outside contractors or professionals, make sure they have experience cleaning up mold, check their references, and have them follow the recommendations presented in this document, the guidelines of the American Conference of Government Industrial Hygienists (ACGIH) (see Resources List), and/or guidelines from other professional organizations.

Molds can be found almost anywhere; they can grow on virtually any organic substance, as long as moisture and oxygen are present. There are molds that can grow on wood, paper, carpet, foods, and insulation. When excessive moisture accumulates in buildings or on building materials, mold growth will often occur, particularly if the moisture problem remains undiscovered or unaddressed. It is impossible to eliminate all mold and mold spores in the indoor environment. However, mold growth can be controlled indoors by controlling moisture indoors.

Molds reproduce by making spores that usually cannot be seen without magnification. Mold spores waft through the indoor and outdoor air continually. When mold spores land on a damp spot indoors, they may begin growing and digesting whatever they are growing on in order to survive. Molds gradually destroy the things they grow on.

Many types of molds exist. All molds have the potential to cause health effects. Molds can produce allergens that can trigger allergic reactions or even asthma attacks in people allergic to mold. Others are known to produce potent toxins and/or irritants. Potential health concerns are an important reason to prevent mold growth and to remediate/clean up any existing indoor mold growth.

Since mold requires water to grow, it is important to prevent moisture problems in buildings. Moisture problems can have many causes, including uncontrolled humidity. Some moisture problems in buildings have been linked to changes in building construction practices during the 1970s, '80s, and '90s. Some of these changes have resulted in buildings that are tightly sealed, but may lack adequate ventilation, potentially leading to moisture buildup. Building materials, such as drywall, may not allow moisture to escape easily. Moisture problems may include roof leaks, landscaping or gutters that direct water into or under the building, and unvented combustion appliances. Delayed maintenance or insufficient maintenance are also associated with moisture problems in schools and large buildings. Moisture problems in portable classrooms and other temporary structures have frequently been associated with mold problems.

When mold growth occurs in buildings, adverse health problems may be reported by some building occupants, particularly those with allergies or respiratory problems. Remediators should avoid exposing themselves and others to mold-laden dusts as they conduct their cleanup activities. Caution should be used to prevent mold and mold spores from being dispersed throughout the air where they can be inhaled by building occupants.

Prevention

The key to mold control is moisture control. Solve moisture problems before they become mold problems!

Mold Prevention Tips

- Fix leaky plumbing and leaks in the building envelope as soon as possible.
- Watch for condensation and wet spots. Fix source(s) of moisture problem(s) as soon as possible.
- Prevent moisture due to condensation by increasing surface temperature or reducing the moisture level in air (humidity). To increase surface temperature, insulate or increase air circulation. To reduce the moisture level in air, repair leaks, increase ventilation (if outside air is cold and dry), or dehumidify (if outdoor air is warm and humid).
- Keep heating, ventilation, and air conditioning (HVAC) drip pans clean, flowing properly, and unobstructed.
- Vent moisture-generating appliances, such as dryers, to the outside where possible.
- Maintain low indoor humidity, below 60% relative humidity (RH), ideally 30 – 50%, if possible.
- Perform regular building/HVAC inspections and maintenance as scheduled.
- Clean and dry wet or damp spots within 48 hours.
- Don't let foundations stay wet. Provide drainage and slope the ground away from the foundation.

Investigating, Evaluating, and Remediating Moisture and Mold Problems

Safety Tips While Investigating and Evaluating Mold and Moisture Problems

- Do not touch mold or moldy items with bare hands.
- Do not get mold or mold spores in your eyes.
- Do not breathe in mold or mold spores.
- Consult Table 2 and text for Personal Protective Equipment (PPE) and containment guidelines.
- Consider using PPE when disturbing mold. The minimum PPE is an N-95 respirator, gloves, and eye protection.

Moldy Areas Encountered During an Investigation

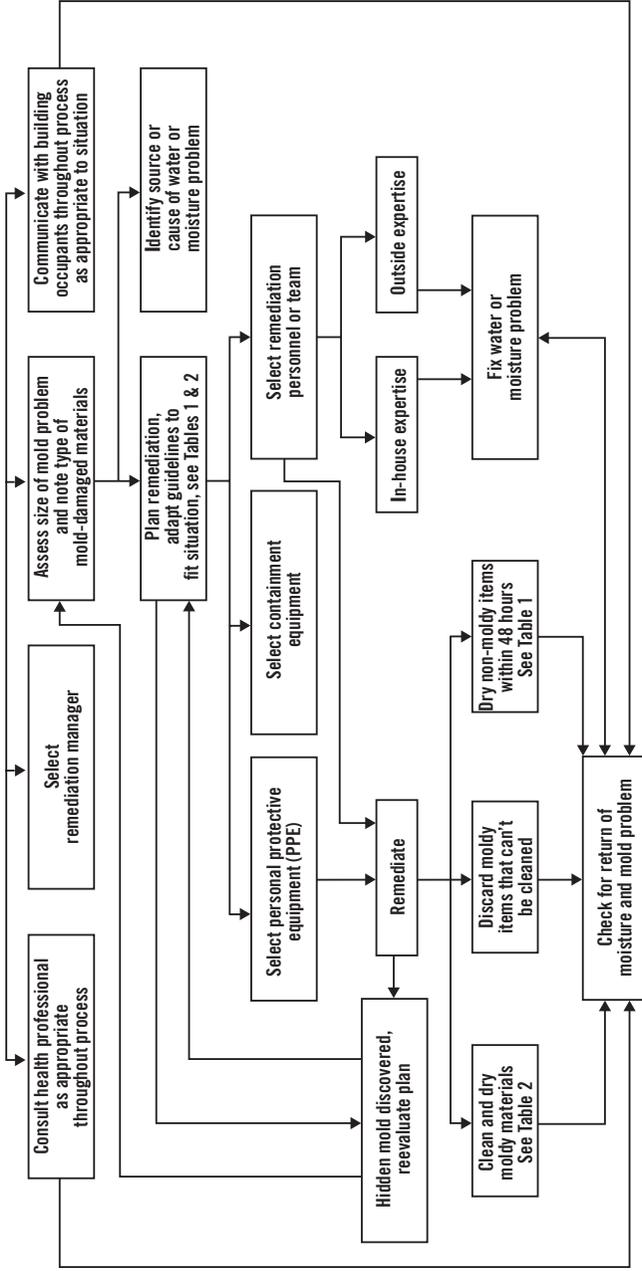


Photo 3A: Mold growing in closet as a result of condensation from room air



Photo 3B: Front side of wallboard looks fine, but the back side is covered with mold

Mold Remediation – Key Steps



Plan the Remediation Before Starting Work

Questions to Consider Before Remediating

- Are there existing moisture problems in the building?
- Have building materials been wet more than 48 hours? (See Table 2 and text)
- Are there hidden sources of water or is the humidity too high (high enough to cause condensation)?
- Are building occupants reporting musty or moldy odors?
- Are building occupants reporting health problems?
- Are building materials or furnishings visibly damaged?
- Has maintenance been delayed or the maintenance plan been altered?
- Has the building been recently remodeled or has building use changed?
- Is consultation with medical or health professionals indicated?

Remediation Plan

Assess the size of the mold and/or moisture problem and the type of damaged materials before planning the remediation work.

Select a remediation manager for medium or large jobs (or small jobs requiring more than one person). The remediation plan should include steps to fix the water or moisture problem, or the problem may reoccur. The plan should cover the use of appropriate Personal Protective Equipment (PPE) and include steps to carefully contain and remove moldy building materials to avoid spreading the mold.²

A remediation plan may vary greatly depending on the size and complexity of the job, and may require revision if circumstances change or new facts are discovered.

The remediation manager's highest priority must be to protect the health and safety of the building occupants and remediators. It is also important to communicate with building occupants when mold problems are identified.³ In some cases,

²Molds are known allergens and may be toxic. You may wish to use Personal Protective Equipment (PPE) while investigating a mold problem, as well as during remediation/cleanup situations. The minimum PPE includes an N-95 respirator, gloves, and eye protection.

³See Appendix C.

especially those involving large areas of contamination, the remediation plan may include temporary relocation of some or all of the building occupants. The decision to relocate occupants should consider the size and type of the area affected by mold growth, the type and extent of health effects reported by the occupants, the potential health risks that could be associated with debris, and the amount of disruption likely to be caused by remediation activities. If possible, remediation activities should be scheduled for off-hours when building occupants are less likely to be affected.

Remediators, particularly those with health-related concerns, may wish to check with their doctors or health care professionals before working on mold remediation or investigating potentially moldy areas. If you have any doubts or questions, you should consult a health professional before beginning a remediation project.

HVAC System

Do not run the HVAC system if you know or suspect that it is contaminated with mold. If you suspect that it may be contaminated (it is part of an identified moisture problem, for instance, or there is mold growth near the intake to the system), consult EPA's guide *Should You Have the Air Ducts in Your Home Cleaned?*⁴ before taking further action (see Resources List).



Photo 4A: Contaminated fibrous insulation inside air handler cover



Photo 4B: Mold growth on air diffuser in ceiling



Photo 4C: Moldy air duct

⁴Although this document has a residential focus, it is applicable to other building types.

Hidden Mold

In some cases, indoor mold growth may not be obvious. It is possible that mold may be growing on hidden surfaces, such as the back side of drywall, wallpaper, or paneling, the top of ceiling tiles, the underside of carpets and pads, etc. Possible locations of hidden mold can include pipe chases and utility tunnels (with leaking or condensing pipes), walls behind furniture (where condensation forms), condensate drain pans inside air handling units, porous thermal or acoustic liners inside ductwork, or roof materials above ceiling tiles (due to roof leaks or insufficient insulation). Some building materials, such as drywall with vinyl wallpaper over it or wood paneling, may act as vapor barriers,⁵ trapping moisture underneath their surfaces and thereby providing a moist environment where mold can grow. You may suspect hidden mold if a building smells moldy, but you cannot see the source, or if you know there has been water damage and building occupants are reporting health problems. Investigating hidden mold

Hidden Mold Growth



Photo 5: Mold growth behind wallpaper

problems may be difficult and will require caution when the investigation involves disturbing potential sites of mold growth—make sure to use PPE. For example, removal of wallpaper can lead to a massive release of spores from mold growing on the underside of the paper. If you believe that you may have a hidden mold problem, you may want to consider hiring an experienced professional. If you discover hidden mold, you should revise your remediation plan to account for the total area affected by mold growth.

⁵For more information on vapor barriers and building construction, see Resources List. It is important that building materials be able to dry; moisture should not be trapped between two vapor barriers or mold may result.

Remediation

1. Fix the water or humidity problem. Complete and carry out repair plan if appropriate. Revise and/or carry out maintenance plan if necessary. Revise remediation plan, as necessary, if more damage is discovered during remediation. See Mold Remediation – Key Steps (page 5) and Resources List (page 29) for additional information.
2. Continue to communicate with building occupants, as appropriate to the situation. Be sure to address all concerns.
3. Completely clean up mold and dry water-damaged areas. Select appropriate cleaning and drying methods for damaged/contaminated materials. Carefully contain and remove moldy building materials. Use appropriate Personal Protective Equipment (PPE). Arrange for outside professional support if necessary.

The Key to Mold Control is Moisture Control!

- When addressing mold problems, don't forget to address the source of the moisture problem, or the mold problem may simply reappear!
- Remember to check for high humidity and condensation problems as well as actual water leaks, maintenance issues, and HVAC system problems.
- Protect the health and safety of the building occupants and remediators. Consult a health professional as needed. Use PPE and containment as appropriate when working with mold.

Table 1: Water Damage Cleanup and Mold Prevention⁶

Table 1 presents strategies to respond to water damage within 24 – 48 hours. These guidelines are designed to help avoid the need for remediation of mold growth by taking quick action before growth starts. If mold growth is found on the materials listed in Table 1, refer to Table 2 for guidance on remediation. Depending on the size of the area involved and resources available, professional assistance may be needed to dry an area quickly and thoroughly.

⁶Please note that Tables 1 and 2 contain general guidelines. Their purpose is to provide basic information for remediation managers to first assess the extent of the damage and then to determine whether the remediation should be managed by in-house personnel or outside professionals. The remediation manager can then use the guidelines to help design a remediation plan or to assess a plan submitted by outside professionals.

Table 1: Water Damage – Cleanup and Mold Prevention

| Guidelines for Response to Clean Water Damage within 24 – 48 Hours to Prevent Mold Growth* | |
|--|--|
| Water-Damaged Material† | Actions |
| Books and papers | <ul style="list-style-type: none"> * For non-valuable items, discard books and papers. * Photocopy valuable/important items, discard originals. * Freeze (in frost-free freezer or meat locker) or freeze-dry. |
| Carpet and backing – dry within 24 – 48 hours§ | <ul style="list-style-type: none"> * Remove water with water extraction vacuum. * Reduce ambient humidity levels with dehumidifier. * Accelerate drying process with fans. |
| Ceiling tiles | <ul style="list-style-type: none"> * Discard and replace. |
| Cellulose insulation | <ul style="list-style-type: none"> * Discard and replace. |
| Concrete or cinder block surfaces | <ul style="list-style-type: none"> * Remove water with water extraction vacuum. * Accelerate drying process with dehumidifiers, fans, and/or heaters. |
| Fiberglass insulation | <ul style="list-style-type: none"> * Discard and replace. |
| Hard surface, porous flooring§ (Linoleum, ceramic tile, vinyl) | <ul style="list-style-type: none"> * Vacuum or damp wipe with water and mild detergent and allow to dry; scrub if necessary. * Check to make sure underflooring is dry; dry underflooring if necessary. |
| Non-porous, hard surfaces (Plastics, metals) | <ul style="list-style-type: none"> * Vacuum or damp wipe with water and mild detergent and allow to dry; scrub if necessary. |
| Upholstered furniture | <ul style="list-style-type: none"> * Remove water with water extraction vacuum. * Accelerate drying process with dehumidifiers, fans, and/or heaters. * May be difficult to completely dry within 48 hours. If the piece is valuable, you may wish to consult a restoration/water damage professional who specializes in furniture. |
| Wallboard (Drywall and gypsum board) | <ul style="list-style-type: none"> * May be dried in place if there is no obvious swelling and the seams are intact. If not, remove, discard, and replace. * Ventilate the wall cavity, if possible. |
| Window drapes | <ul style="list-style-type: none"> * Follow laundering or cleaning instructions recommended by the manufacturer. |
| Wood surfaces | <ul style="list-style-type: none"> * Remove moisture immediately and use dehumidifiers, gentle heat, and fans for drying. (Use caution when applying heat to hardwood floors.) * Treated or finished wood surfaces may be cleaned with mild detergent and clean water and allowed to dry. * Wet paneling should be pried away from wall for drying. |
| <p>*If mold growth has occurred or materials have been wet for more than 48 hours, consult Table 2 guidelines. Even if materials are dried within 48 hours, mold growth may have occurred. Items may be tested by professionals if there is doubt. Note that mold growth will not always occur after 48 hours; this is only a guideline.</p> <p>These guidelines are for damage caused by clean water. If you know or suspect that the water source is contaminated with sewage, or chemical or biological pollutants, then Personal Protective Equipment and containment are required by the Occupational Safety and Health Administration (OSHA). An experienced professional should be consulted if you and/or your remediators do not have expertise remediating in contaminated water situations. Do not use fans before determining that the water is clean or sanitary.</p> <p>† If a particular item(s) has high monetary or sentimental value, you may wish to consult a restoration/water damage specialist.</p> <p>§ The subfloor under the carpet or other flooring material must also be cleaned and dried. See the appropriate section of this table for recommended actions depending on the composition of the subfloor.</p> | |

Table 2: Mold Remediation Guidelines⁷

Table 2 presents remediation guidelines for building materials that have or are likely to have mold growth. The guidelines in Table 2 are designed to protect the health of occupants and cleanup personnel during remediation.

Mold and Indoor Air Regulations and Standards

Standards or Threshold Limit Values (TLVs) for airborne concentrations of mold, or mold spores, have not been set. As of December 2000, there are no EPA regulations or standards for airborne mold contaminants.

These guidelines are based on the area and type of material affected by water damage and/or mold growth. Please note that these are guidelines; some professionals may prefer other cleaning methods. If you are considering cleaning your ducts as part of your remediation plan, you should consult EPA's publication entitled, *Should You Have the Air Ducts In Your Home*

*Cleaned?*⁸ (see Resources List). If possible, remediation activities should be scheduled for off-hours when building occupants are less likely to be affected.

Although the level of personal protection suggested in these guidelines is based on the total surface area contaminated and the potential for remediator and/or occupant exposure, professional judgment should always play a part in remediation decisions. These remediation guidelines are based on the size of the affected area to make it easier for remediators to select appropriate techniques, not on the basis of health effects or research showing there is a specific method appropriate at a certain number of square feet. The guidelines have been designed to help construct a remediation plan. The remediation manager will then use professional judgment and experience to adapt the guidelines to particular situations. When in doubt, caution is advised. Consult an experienced mold remediator for more information.

⁷Please note that Tables 1 and 2 contain general guidelines. Their purpose is to provide basic information for remediation managers to first assess the extent of the damage and then to determine whether the remediation should be managed by in-house personnel or outside professionals. The remediation manager can then use the guidelines to help design a remediation plan or to assess a plan submitted by outside professionals.

⁸Although this document has a residential focus, it is applicable to other building types.

In cases in which a particularly toxic mold species has been identified or is suspected, when extensive hidden mold is expected (such as behind vinyl wallpaper or in the HVAC system), when the chances of the mold becoming airborne are estimated to be high, or sensitive individuals (e.g., those with severe allergies or asthma) are present, a more cautious or conservative approach to remediation is indicated. Always make sure to protect remediators and building occupants from exposure to mold.

Health Concerns

If building occupants are reporting serious health concerns, you should consult a health professional.

Table 2: Guidelines for Remediating Building Materials with Mold Growth Caused by Clean Water*

| Material or Furnishing Affected | Cleanup Methods† | Personal Protective Equipment | Containment |
|---|------------------|--|---|
| SMALL – Total Surface Area Affected Less Than 10 square feet (ft²) | | | |
| Books and papers | 3 | Minimum N-95 respirator, gloves, and goggles | None required |
| Carpet and backing | 1, 3 | | |
| Concrete or cinder block | 1, 3 | | |
| Hard surface, porous flooring (Linoleum, ceramic tile, vinyl) | 1, 2, 3 | | |
| Non-porous, hard surfaces (Plastics, metals) | 1, 2, 3 | | |
| Upholstered furniture & drapes | 1, 3 | | |
| Wallboard (Drywall and gypsum board) | 3 | | |
| Wood surfaces | 1, 2, 3 | | |
| MEDIUM – Total Surface Area Affected Between 10 and 100 (ft²) | | | |
| Books and papers | 3 | Limited or Full Use professional judgment, consider potential for remediator exposure and size of contaminated area | Limited Use professional judgment, consider potential for remediator/occupant exposure and size of contaminated area |
| Carpet and backing | 1, 3, 4 | | |
| Concrete or cinder block | 1, 3 | | |
| Hard surface, porous flooring (Linoleum, ceramic tile, vinyl) | 1, 2, 3 | | |
| Non-porous, hard surfaces (Plastics, metals) | 1, 2, 3 | | |
| Upholstered furniture & drapes | 1, 3, 4 | | |
| Wallboard (Drywall and gypsum board) | 3, 4 | | |
| Wood surfaces | 1, 2, 3 | | |
| LARGE – Total Surface Area Affected Greater Than 100 (ft²) or Potential for Increased Occupant or Remediator Exposure During Remediation Estimated to be Significant | | | |
| Books and papers | 3 | Full Use professional judgment, consider potential for remediator exposure and size of contaminated area | Full Use professional judgment, consider potential for remediator/occupant exposure and size of contaminated area |
| Carpet and backing | 1, 3, 4 | | |
| Concrete or cinder block | 1, 3 | | |
| Hard surface, porous flooring (Linoleum, ceramic tile, vinyl) | 1, 2, 3, 4 | | |
| Non-porous, hard surfaces (Plastics, metals) | 1, 2, 3 | | |
| Upholstered furniture & drapes | 1, 3, 4 | | |
| Wallboard (Drywall and gypsum board) | 3, 4 | | |
| Wood surfaces | 1, 2, 3, 4 | | |

Table 2 continued

*Use professional judgment to determine prudent levels of Personal Protective Equipment and containment for each situation, particularly as the remediation site size increases and the potential for exposure and health effects rises. Assess the need for increased Personal Protective Equipment, if, during the remediation, more extensive contamination is encountered than was expected. Consult Table 1 if materials have been wet for less than 48 hours, and mold growth is not apparent.

These guidelines are for damage caused by clean water. If you know or suspect that the water source is contaminated with sewage, or chemical or biological pollutants, then the Occupational Safety and Health Administration (OSHA) requires PPE and containment. An experienced professional should be consulted if you and/or your remediators do not have expertise in remediating contaminated water situations.

[†]Select method most appropriate to situation. Since molds gradually destroy the things they grow on, if mold growth is not addressed promptly, some items may be damaged such that cleaning will not restore their original appearance. If mold growth is heavy and items are valuable or important, you may wish to consult a restoration/water damage/remediation expert. Please note that these are guidelines; other cleaning methods may be preferred by some professionals.

CLEANUP METHODS

Method 1: Wet vacuum (in the case of porous materials, some mold spores/fragments will remain in the material but will not grow if the material is completely dried). Steam cleaning may be an alternative for carpets and some upholstered furniture.

Method 2: Damp-wipe surfaces with plain water or with water and detergent solution (except wood—use wood floor cleaner); scrub as needed.

Method 3: High-efficiency particulate air (HEPA) vacuum after the material has been thoroughly dried. Dispose of the contents of the HEPA vacuum in well-sealed plastic bags.

Method 4: Discard – remove water-damaged materials and seal in plastic bags while inside of containment, if present. Dispose of as normal waste. HEPA vacuum area after it is dried.

PERSONAL PROTECTIVE EQUIPMENT (PPE)

Minimum: Gloves, N-95 respirator, goggles/eye protection

Limited: Gloves, N-95 respirator or half-face respirator with HEPA filter, disposable overalls, goggles/eye protection

Full: Gloves, disposable full body clothing, head gear, foot coverings, full-face respirator with HEPA filter

CONTAINMENT

Limited: Use polyethylene sheeting ceiling to floor around affected area with a slit entry and covering flap; maintain area under negative pressure with HEPA-filtered fan unit. Block supply and return air vents within containment area.

Full: Use two layers of fire-retardant polyethylene sheeting with one airlock chamber. Maintain area under negative pressure with HEPA-filtered fan exhausted outside of building. Block supply and return air vents within containment area.

Table developed from literature and remediation documents including *Bioaerosols: Assessment and Control* (American Conference of Governmental Industrial Hygienists, 1999) and *IICRC S500, Standard and Reference Guide for Professional Water Damage Restoration* (Institute of Inspection, Cleaning and Restoration, 1999); see Resources List for more information.

Cleanup Methods

A variety of mold cleanup methods are available for remediating damage to building materials and furnishings caused by moisture control problems and mold growth. The specific method or group of methods used will depend on the type of material affected, as presented in Table 2. Please note that professional remediators may use some methods not covered in these guidelines; absence of a method in the guidelines does not necessarily mean that it is not useful.⁹

Method 1: Wet Vacuum

Wet vacuums are vacuum cleaners designed to collect water. They can be used to remove water from floors, carpets, and hard surfaces where water has accumulated. They should not be used to vacuum porous materials,



Photo 6: Heavy mold growth on underside of spruce floorboards

Molds Can Damage Building Materials and Furnishings

Mold growth can eventually cause structural damage to a school or large building, if a mold/moisture problem remains unaddressed for a long time. In the case of a long-term roof leak, for example, molds can weaken floors and walls as the molds feed on wet wood. If you suspect that mold has damaged building integrity, you should consult a structural engineer or other professional with expertise in this area.

⁹If you are unsure what to do, or if the item is expensive or of sentimental value, you may wish to consult a specialist. Specialists in furniture repair/restoration, painting, art restoration and conservation, carpet and rug cleaning, water damage, and fire/water restoration are commonly listed in phone books. Be sure to ask for and check references; look for affiliation with professional organizations. See Resources List.

such as gypsum board. They should be used only when materials are still wet—wet vacuums may spread spores if sufficient liquid is not present. The tanks, hoses, and attachments of these vacuums should be thoroughly cleaned and dried after use since mold and mold spores may stick to the surfaces.

Method 2: Damp Wipe

Whether dead or alive, mold is allergenic, and some molds may be toxic. Mold can generally be removed from non-porous (hard) surfaces by wiping or scrubbing

with water, or water and detergent. It is important to dry these surfaces quickly and thoroughly to discourage further mold growth. Instructions for cleaning surfaces, as listed on product labels, should always be read and followed. Porous materials that are wet and have mold growing on them may have to be discarded. Since molds will infiltrate porous substances and grow on or fill in empty spaces or crevices, the mold can be difficult or impossible to remove completely.

Mold and Paint

Don't paint or caulk moldy surfaces; clean and dry surfaces before painting. Paint applied over moldy surfaces is likely to peel.

Method 3: HEPA Vacuum

HEPA (High-Efficiency Particulate Air) vacuums are recommended for final cleanup of remediation areas after materials have been thoroughly dried and contaminated materials removed. HEPA vacuums are also recommended for cleanup of dust that may have settled on surfaces outside the remediation area. Care must be taken to ensure that the filter is properly seated in the vacuum so that all the air must pass through the filter. When changing the vacuum filter, remediators should wear PPE to prevent exposure to the mold that has been captured. The filter and contents of the HEPA vacuum must be disposed of in well-sealed plastic bags.

Mold Remediation/Cleanup and Biocides

The purpose of mold remediation is to remove the mold to prevent human exposure and damage to building materials and furnishings. It is necessary to clean up mold contamination, not just to kill the mold. Dead mold is still allergenic, and some dead molds are potentially toxic. The use of a biocide, such as chlorine bleach, is not recommended as a routine practice during mold remediation, although there may be instances where professional judgment may indicate its use (for example, when immune-compromised individuals are present). In most cases, it is not possible or desirable to sterilize an area; a background level of mold spores will remain in the air (roughly equivalent to or lower than the level in outside air). These spores will not grow if the moisture problem in the building has been resolved.

If you choose to use disinfectants or biocides, always ventilate the area. Outdoor air may need to be brought in with fans. When using fans, take care not to distribute mold spores throughout an unaffected area. Biocides are toxic to humans, as well as to mold. You should also use appropriate PPE and read and follow label precautions. Never mix chlorine bleach solution with cleaning solutions or detergents that contain ammonia; toxic fumes could be produced.

Some biocides are considered pesticides, and some States require that only registered pesticide applicators apply these products in schools. Make sure anyone applying a biocide is properly licensed, if necessary. Fungicides are commonly applied to outdoor plants, soil, and grains as a dust or spray—examples include hexachlorobenzene, organomercurials, pentachlorophenol, phthalimides, and dithiocarbamates. Do not use fungicides developed for use outdoors for mold remediation or for any other indoor situation.

Method 4: Discard – Remove Damaged Materials and Seal in Plastic Bags

Building materials and furnishings that are contaminated with mold growth and are not salvageable should be double-bagged using 6-mil polyethylene sheeting. These materials can then usually be discarded as ordinary construction waste. It is important to package mold-contaminated materials in sealed bags before removal from the containment area to minimize the dispersion of mold spores throughout the building. Large items that have heavy mold growth

should be covered with polyethylene sheeting and sealed with duct tape before they are removed from the containment area.

Personal Protective Equipment (PPE)

If the remediation job disturbs mold and mold spores become airborne, then the risk of respiratory exposure goes up. Actions that are likely to stir up mold include: breakup of moldy porous materials such as wallboard; invasive procedures used to examine or remediate mold growth in a wall cavity; actively stripping or peeling wallpaper to remove it; and using fans to dry items.

Always use gloves and eye protection when cleaning up mold!

The primary function of Personal Protective Equipment (PPE) is to avoid inhaling mold and mold spores and to avoid mold contact with the skin or eyes. The following sections discuss the different types of PPE that can be used during remediation activities. Please note that all individuals using certain PPE equipment, such as half-face or full-face respirators, must be trained, must have medical clearance, and must be fit-tested by a trained professional. In addition, the use of respirators must follow a complete respiratory protection program as specified by the Occupational Safety and Health Administration (OSHA) (see Resources List for more information).

Skin and Eye Protection

Gloves are required to protect the skin from contact with mold allergens (and in some cases mold toxins) and from potentially irritating cleaning solutions. Long gloves that extend to the middle of the forearm are recommended. The glove material should

Personal Protective Equipment



Photo 7: Remediation worker with limited PPE

be selected based on the type of materials being handled. If you are using a biocide (such as chlorine bleach) or a strong cleaning solution, you should select gloves made from natural rubber, neoprene, nitrile, polyurethane, or PVC. If you are using a mild detergent or plain water, ordinary household rubber gloves may be used.

To protect your eyes, use properly fitted goggles or a full-face respirator with HEPA filter. Goggles must be designed to prevent the entry of dust and small particles. Safety glasses or goggles with open vent holes are not acceptable.

Respiratory Protection

Respirators protect cleanup workers from inhaling airborne mold, mold spores, and dust.

Minimum: When cleaning up a small area affected by mold, you should use an N-95 respirator. This device covers the nose and mouth, will filter out 95% of the particulates in the air, and is available in most hardware stores.

Limited: Limited PPE includes use of a half-face or full-face air purifying respirator (APR) equipped with a HEPA filter cartridge. These respirators contain both inhalation and exhalation valves that filter the air and ensure that it is free of mold particles. Note that half-face APRs do not provide eye protection. In addition, the HEPA filters do not remove vapors or gases. You should always use respirators approved by the National Institute for Occupational Safety and Health (see Resources List).

Full: In situations in which high levels of airborne dust or mold spores are likely or when intense or long-term exposures are expected (e.g., the cleanup of large areas of contamination), a full-face, powered air purifying respirator (PAPR) is recommended. Full-face PAPRs use a blower to force air through a HEPA filter. The HEPA-filtered air is supplied to a mask that covers the entire face or a hood that covers the entire head. The positive pressure within the hood prevents unfiltered air from entering through penetrations or gaps. Individuals must be trained to use their respirators before they begin remediation. The use of these respirators must be in compliance with OSHA regulations (see Resources List).

Disposable Protective Clothing

Disposable clothing is recommended during a medium or large remediation project to prevent the transfer and spread of mold to clothing and to eliminate skin contact with mold.

Limited: Disposable paper overalls can be used.

Full: Mold-impervious disposable head and foot coverings, and a body suit made of a breathable material, such as TYVEK®, should be used. All gaps, such as those around ankles and wrists, should be sealed (many remediators use duct tape to seal clothing).

Containment

The purpose of containment during remediation activities is to limit release of mold into the air and surroundings, in order to minimize the exposure of remediators and building occupants to mold. Mold and moldy debris should not be allowed to spread to areas in the building beyond the contaminated site.

The two types of containment recommended in Table 2 are limited and full. The larger the area of moldy material, the greater the possibility of human exposure and the greater the need for containment. In general, the size of the area helps determine the level of containment. However, a heavy growth of mold in a relatively small area could release more spores than a lighter growth of mold in a relatively large area. Choice of containment should be based on professional judgment.¹⁰ The primary object of containment should be to prevent occupant and remediation exposure to mold.

Containment Tips

- Always maintain the containment area under negative pressure.
- Exhaust fans to outdoors and ensure that adequate makeup air is provided.
- If the containment is working, the polyethylene sheeting should billow inwards on all surfaces. If it flutters or billows outward, containment has been lost, and you should find and correct the problem before continuing your remediation activities.

¹⁰For example, a remediation professional may decide that a small area that is extensively contaminated and has the potential to distribute mold to occupied areas during cleanup should have full containment, whereas a large wall surface that is lightly contaminated and easily cleaned would require only limited containment.

Limited Containment

Limited containment is generally recommended for areas involving between 10 and 100 square feet (ft²) of mold contamination. The enclosure around the moldy area should consist of a single layer of 6-mil, fire-retardant polyethylene sheeting. The containment should have a slit entry and covering flap on the outside of the containment area. For small areas, the polyethylene sheeting can be affixed to floors and ceilings with duct tape.

Containment Area



Photo 8: Full containment on large job

For larger areas, a steel or wooden stud frame can be erected and polyethylene sheeting attached to it. All supply and air vents, doors, chases, and risers within the containment area must be sealed with polyethylene sheeting to minimize the migration of contaminants to other parts of the building. Heavy mold growth on ceiling tiles may impact HVAC systems if the space above the ceiling is used as a return air plenum. In this case, containment should be installed from the floor to the ceiling deck, and the filters in the air handling units serving the affected area may have to be replaced once remediation is finished.

The containment area must be maintained under negative pressure relative to surrounding areas. This will ensure that contaminated air does not flow into adjacent areas. This can be done with a HEPA-filtered fan unit exhausted outside of the building. For small, easily contained areas, an exhaust fan ducted to the outdoors

can also be used. The surfaces of all objects removed from the containment area should be remediated/cleaned prior to removal. The remediation guidelines outlined in Table 2 can be implemented when the containment is completely sealed and is under negative pressure relative to the surrounding area.

Full Containment

Full containment is recommended for the cleanup of mold-contaminated surface areas greater than 100 ft² or in any situation in which it appears likely that the occupant space would be further contaminated without full containment. Double layers of polyethylene should be used to create a barrier between the moldy area and other parts of the building. A decontamination chamber or airlock should be constructed for entry into and exit from the remediation area. The entryways to the airlock from the outside and from the airlock to the main containment area should consist of a slit entry with covering flaps on the outside surface of each slit entry. The chamber should be large enough to hold a waste container and allow a person to put on and remove PPE. All contaminated PPE, except respirators, should be placed in a sealed bag while in this chamber. Respirators should be worn until remediators are outside the decontamination chamber. PPE must be worn throughout the final stages of HEPA vacuuming and damp-wiping of the contained area. PPE must also be worn during HEPA vacuum filter changes or cleanup of the HEPA vacuum.

Equipment

Moisture Meters: Measure/Monitor Moisture Levels in Building Materials

Moisture meters may be helpful for measuring the moisture content in a variety of building materials following water damage. They can also be used to monitor the process of drying damaged materials. These direct reading devices have a thin probe which can be inserted into the material to be tested or can be pressed directly against the surface of the material. Moisture meters can be used on materials such as carpet, wallboard, wood, brick, and concrete.

Moisture Meter



Photo 9: Moisture meter measuring moisture content of plywood subfloor

Humidity Gauges or Meters: Monitor Moisture Levels in the Air

Humidity meters can be used to monitor humidity indoors. Inexpensive (<\$50) models are available that monitor both temperature and humidity.

Humidistat: Turns on HVAC System at Specific Relative Humidity (RH)

A humidistat is a control device that can be connected to the HVAC system and adjusted so that, if the humidity level rises above a set point, the HVAC system will automatically come on.

HVAC System Filter: Filters Outdoor Air

Use high-quality filters in your HVAC system during remediation. Consult an engineer for the appropriate efficiency for your specific HVAC system and consider upgrading your filters if appropriate. Conventional HVAC filters are typically not effective in filtering particles the size of mold spores. Consider upgrading to a filter with a minimum efficiency of 50 to 60% or a rating of MERV 8, as determined by Test Standard 52.2 of the American Society of Heating, Refrigerating, and Air Conditioning Engineers. Remember to change filters regularly and change them following any remediation activities.

Sampling

Is sampling for mold needed? In most cases, if visible mold growth is present, sampling is unnecessary. In specific instances, such as cases where litigation is involved, the source(s) of the mold contamination is unclear, or health concerns are a problem, you may consider sampling as part of your site evaluation. Surface sampling may also be useful in order to determine if an area has been adequately cleaned or remediated. Sampling should be done only after developing a sampling plan that includes a confirmable theory regarding suspected mold sources and routes of exposure. Figure out what you think is happening and how to prove or disprove it before you sample!

If you do not have extensive experience and/or are in doubt about sampling, consult an experienced professional. This individual can help you decide if sampling for mold is useful and/or needed, and will be able to carry out any necessary sampling. It is important to remember that the results of sampling may have limited use or application. Sampling may help locate the source of mold contamination, identify some of the mold species present, and differentiate between mold and soot or dirt. Pre- and post-remediation sampling may also be useful in determining whether remediation efforts have been effective. After remediation, the types and concentrations of mold in indoor air samples should be similar to what is found in the local outdoor air. Since no EPA or other Federal threshold limits have been set for mold or mold spores, sampling cannot be used to check a building's compliance with Federal mold standards.

Sampling for mold should be conducted by professionals with specific experience in designing mold sampling protocols, sampling methods, and interpretation of results. Sample analysis should follow analytical methods recommended by the American Industrial Hygiene Association (AIHA), the American Conference of Governmental Industrial Hygienists (ACGIH), or other professional guidelines (see Resources List). Types of samples include air samples, surface samples, bulk samples (chunks of carpet, insulation, wallboard, etc.), and water samples from condensate drain pans or cooling towers.

A number of pitfalls may be encountered when inexperienced personnel conduct sampling. They may take an inadequate number of samples, there may be inconsistency in sampling protocols, the samples may become contaminated, outdoor control samples may be omitted, and you may incur costs for unneeded or inappropriate samples. Budget constraints will often be a consideration when sampling; professional advice may be necessary to determine if it is possible to take sufficient samples to characterize a problem on a given budget. If it is not possible to sample properly, with a sufficient number of samples to answer the question(s) posed, it would be preferable not to sample. Inadequate sample plans may generate misleading, confusing, and useless results.

Keep in mind that air sampling for mold provides information only for the moment in time in which the sampling occurred, much like a snapshot. Air sampling will reveal, when properly done, what was in the air at the moment when the sample was taken. For someone without experience, sampling results will be difficult to interpret. Experience in interpretation of results is essential.

How Do You Know When You Have Finished Remediation/Cleanup?

1. You must have completely fixed the water or moisture problem.
2. You should complete mold removal. Use professional judgment to determine if the cleanup is sufficient. Visible mold, mold-damaged materials, and moldy odors should not be present.
3. If you have sampled, the kinds and concentrations of mold and mold spores in the building should be similar to those found outside, once cleanup activities have been completed.
4. You should revisit the site(s) shortly after remediation, and it should show no signs of water damage or mold growth.
5. People should be able to occupy or re-occupy the space without health complaints or physical symptoms.
6. Ultimately, this is a judgment call; there is no easy answer.

Checklist for Mold Remediation*

Investigate and evaluate moisture and mold problems

- Assess size of moldy area (square feet)
- Consider the possibility of hidden mold
- Clean up small mold problems and fix moisture problems before they become large problems
- Select remediation manager for medium or large size mold problem
- Investigate areas associated with occupant complaints
- Identify source(s) or cause of water or moisture problem(s)
- Note type of water-damaged materials (wallboard, carpet, etc.)
- Check inside air ducts and air handling unit
- Throughout process, consult qualified professional if necessary or desired

Communicate with building occupants at all stages of process, as appropriate

- Designate contact person for questions and comments about medium or large scale remediation as needed

Plan remediation

- Adapt or modify remediation guidelines to fit your situation; use professional judgment
- Plan to dry wet, non-moldy materials within 48 hours to prevent mold growth (see Table 1 and text)
- Select cleanup methods for moldy items (see Table 2 and text)
- Select Personal Protection Equipment – protect remediators (see Table 2 and text)
- Select containment equipment – protect building occupants (see Table 2 and text)
- Select remediation personnel who have the experience and training needed to implement the remediation plan and use Personal Protection Equipment and containment as appropriate

Remediate moisture and mold problems

- Fix moisture problem, implement repair plan and/or maintenance plan
- Dry wet, non-moldy materials within 48 hours to prevent mold growth
- Clean and dry moldy materials (see Table 2 and text)
- Discard moldy porous items that can't be cleaned (see Table 2 and text)

*For details, see main text of this publication. Please note that this checklist was designed to highlight key parts of a school or commercial building remediation and does not list all potential steps or problems.

Resources List – EPA

U.S. Environmental Protection Agency (EPA), Indoor Environments Division (IED)

An Office Building Occupant's Guide to IAQ

www.epa.gov/iaq/pubs/occupgd.html

Biological Contaminants

www.epa.gov/iaq/biologic.html

Building Air Quality Action Plan (for Commercial Buildings)

www.epa.gov/iaq/largebldgs/pdf_files/baqactionplan.pdf

Floods / Flooding

www.epa.gov/iaq/flood

Indoor Air Quality (IAQ) Home Page

www.epa.gov/iaq/index.html

IAQ in Large Buildings / Commercial Buildings

www.epa.gov/iaq/largebldgs

IAQ in Schools

www.epa.gov/iaq/schools

Mold Remediation in Schools and Commercial Buildings

www.epa.gov/mold/mold_remediation.html

Mold Resources

www.epa.gov/mold/moldresources.html

Resources List – OTHER

The following list of resources includes information created and maintained by other public and private organizations. The U.S. EPA does not control or guarantee the accuracy, relevance, timeliness, or completeness of this outside information. Further, the inclusion of such resources is not intended to endorse any views expressed or products or services offered by the author of the reference or the organization operating the service on which the reference is maintained.

American College of Occupational and Environmental Medicine (ACOEM)

(847) 818-1800

www.acoem.org/

Referrals to physicians who have experience with environmental exposures

American Conference of Governmental Industrial Hygienists, Inc. (ACGIH)

(513) 742-2020

www.acgih.org

Occupational and environmental health and safety information

American Industrial Hygiene Association (AIHA)

(703) 849-8888

www.aiha.org

Information on industrial hygiene and indoor air quality issues including mold hazards and legal issues

American Society of Heating, Refrigerating, and Air-Conditioning Engineers, Inc. (ASHRAE)

(800) 527-4723

www.ashrae.org

Information on engineering issues and indoor air quality

Association of Occupational and Environmental Clinics (AOEC)

(888) 347-AOEC (2632)

www.aoec.org

Referrals to clinics with physicians who have experience with environmental exposures, including exposures to mold; maintains a database of occupational and environmental cases

Asthma and Allergic Diseases:

American Academy of Allergy, Asthma & Immunology (AAAAI)

(414) 272-6071

www.aaaai.org

Physician referral directory, information on allergies and asthma

Asthma and Allergy Foundation of America (AAFA)

(800) 7-ASTHMA (800-727-8462)

www.aafa.org

Information on allergies and asthma

American Lung Association (ALA)

(800) LUNGUSA (800-586-4872)

www.lungusa.org

Information on allergies and asthma

Asthma and Allergy Network/Mothers of Asthmatics, Inc. (AAN-MA)

(800) 878-4403 or (703) 641-9595

www.aanma.org

Information on allergies and asthma

National Institute of Allergy and Infectious Diseases (NIAID)

(301) 496-5717

www.niaid.nih.gov/

Information on allergies and asthma

National Jewish Medical and Research Center

(800) 222-LUNG (800-222-5864)

www.nationaljewish.org/

Information on allergies and asthma

Canada Mortgage and Housing Corporation (CMHC)

(613) 748-2000 [International]

www.cmhc-schl.gc.ca/

Several documents on mold-related topics available

Carpet and Rug Institute (CRI)

(706) 278-3176

www.carpet-rug.org/

Carpet maintenance, restoration guidelines for water-damaged carpet, other carpet-related issues

Centers for Disease Control and Prevention (CDC)

(800) CDC-INFO (232-4636)

www.cdc.gov

Information on health-related topics including asthma, molds in the environment, and occupational health

CDC's National Center for Environmental Health (NCEH)

(800) CDC-INFO (232-4636)

www.cdc.gov/mold/stachy.htm

Questions and answers on *Stachybotrys chartarum* and other molds

Energy and Environmental Building Association

(952) 881-1098

www.eeba.org

Information on energy-efficient and environmentally responsible buildings, humidity/moisture control/vapor barriers

Floods/ Flooding:

Federal Emergency Management Agency (FEMA)

(800) 621-FEMA (3362)

www.fema.gov/hazard/flood/index.shtm

Publications on floods, flood proofing, etc.

University of Minnesota, Department of Environmental Health & Safety

(612) 626-6002

www.dehs.umn.edu/

Managing water infiltration into buildings

University of Wisconsin-Extension, The Disaster Handbook

(608) 262-3980

www.uwex.edu/ces/news/handbook.html

Information on floods and other natural disasters

Health Canada, Health Protection Branch, Laboratory Centre for Disease Control, Office of Biosafety

(613) 957-1779

www.phac-aspc.gc.ca/msds-ftss

Material Safety Data Sheets with health and safety information on infectious microorganisms, including *Aspergillus* and other molds and airborne biologicals

Indoor Environmental Remediation Board (IERB)

(916) 736-1100

www.ierb.org

Information on best practices in building remediation

Institute of Inspection, Cleaning and Restoration Certification (IICRC)

(360) 693-5675

www.iicrc.org

Information on and standards for the inspection, cleaning, and restoration industry

International Society of Cleaning Technicians (ISCT)

(800) WHY-ISCT (800-949-4728)

Information on cleaning such as stain removal guide for carpets

ISSA—The Worldwide Cleaning Industry Association

(800) 225-4772

www.issa.com

Education and training on cleaning and maintenance

National Air Duct Cleaners Association (NADCA)

(202) 737-2926

www.nadca.com

Duct cleaning information

National Association of the Remodeling Industry (NARI)

(847) 298-9200

www.nari.org

Consumer information on remodeling, including help finding a professional remodeling contractor

National Institute of Building Sciences (NIBS)

(202) 289-7800

<http://nibs.org>

Information on building regulations, science, and technology

National Institute for Occupational Safety and Health (NIOSH)

(800) CDC-INFO (232-4636)

www.cdc.gov/niosh

Health and safety information with a workplace orientation

National Pesticide Information Center (NPIC)

(800) 858-7378

<http://npic.orst.edu/>

Regulatory information, safety information, and product information on antimicrobials

New York City Department of Health and Mental Hygiene

www.nyc.gov/html/doh/html/epi/moldrpt1.shtml

“Guidelines on Assessment and Remediation of Fungi in Indoor Environments”

Occupational Safety & Health Administration (OSHA)

(800) 321-OSHA (800-321-6742)

www.osha.gov

Information on worker safety, includes topics such as respirator use and safety in the workplace

Restoration Industry Association

(800) 272-7012

www.ascr.org/

Disaster recovery, water and fire damage, emergency tips, referrals to professionals

Sheet Metal & Air Conditioning Contractors' National Association (SMACNA)

(703) 803-2980

www.smacna.org

Technical information on topics such as air conditioning and air ducts

Smithsonian Museum Conservation Institute

(301) 238-1240

www.si.edu/mci

Guidelines for caring for and preserving furniture and wooden objects, paper-based materials; preservation studies

University of Michigan Herbarium

(734) 615-6200

www.herbarium.lsa.umich.edu

Specimen-based information on fungi; information on fungal ecology

University of Tulsa Indoor Air Program

(918) 631-5246

www.utulsa.edu/iaqprogram

Courses, classes, and continuing education on indoor air quality

References

- American Academy of Pediatrics, Committee on Environmental Health. "Toxic Effects of Indoor Air Molds." *Pediatrics*. Volume 101, pp. 712-714. 1996.
- American Conference of Governmental Industrial Hygienists. *Bioaerosols: Assessment and Control*. Macher, J., editor. ACGIH. Cincinnati, OH. ISBN 1-882417-29-1. 1999.
- American Conference of Governmental Industrial Hygienists. *Guidelines for the Assessment of Bioaerosols in the Indoor Environment*. ISBN 0-936712-83-X. 1989.
- American Industrial Hygiene Association. *Field Guide for the Determination of Biological Contaminants in Environmental Samples*. Dillon, H. K., Heinsohn, P. A., and Miller, J. D., editors. Fairfax, VA. 1996.
- American Society of Heating, Refrigerating, and Air Conditioning Engineers. *Method of Testing General Ventilation Air-Cleaning Devices for Removal Efficiency by Particle Size*. ASHRAE Standard 52.2. 2000.
- American Society for Microbiology. *Manual of Environmental Microbiology*. Hurst, C., Editor in Chief. ASM Press. Washington, DC. 1997.
- Canada Mortgage and Housing Corporation. *Clean-up Procedures for Mold in Houses*. ISBN 0-662-21133-2. 1993.
- Eastern New York Occupational and Environmental Health Center. *Proceedings of the International Conference*, Saratoga Springs, NY. October 6-7, 1994. *Fungi and Bacteria in Indoor Air Environments - Health Effects, Detection, and Remediation*. Johannning, E., and Yang, C., editors. Eastern New York Occupational Health Program. Latham, NY. 1995.
- Eastern New York Occupational and Environmental Health Center. *Bioaerosols, Fungi and Mycotoxins: Health Effects, Assessment, Prevention and Control*. Johannning, E., editor. Albany, NY. 1999. (Proceedings of the Third International Conference on Fungi, Mycotoxins and Bioaerosols: Health Effects, Assessment, Prevention and Control. September 23-25, 1998.)

- Gravesen, S., Frisvad, J., and Samson, R. *Microfungi*. Munksgaard. Copenhagen, Denmark. 1994.
- “Indoor Mold and Children’s Health.” *Environmental Health Perspectives*, Vol. 107, Suppl. 3, June 1999.
- Institute of Inspection, Cleaning and Restoration Certification, *IICRC S500, Standard and Reference Guide for Professional Water Damage Restoration*, 2nd Edition. 1999.
- Lstiburek, J. *Building Science Corporation Builder’s Guide, Mixed-Humid Climates*. Building Science Corporation and the Energy Efficient Building Association. 1999.
- National Academy of Sciences, Committee on the Assessment of Asthma and Indoor Air. *Clearing the Air: Asthma and Indoor Air Exposures*. National Academy Press. 2000.
- National Academy of Sciences. *Indoor Allergens: Assessing and Controlling Adverse Health Effects*. National Academy Press. 1993.
- National Institute for Occupational Safety and Health. *Guide to the Selection and Use of Particulate Respirators Certified under 42 CFR 84*. DHHS (NIOSH) Publication No. 96-101. January 1996.
- New York City Department of Health, Bureau of Environmental & Occupational Disease Epidemiology. *Guidelines on Assessment and Remediation of Fungi in Indoor Environments*. 2000.
- Occupational Safety & Health Administration. *Respiratory Protection Standard, 29 CFR 1910.134*. 63 FR 1152. January 8, 1998.
- U.S. Environmental Protection Agency. *Should You Have the Air Ducts In Your Home Cleaned?* EPA-402-K-97-002. October 1997.
- U.S. Environmental Protection Agency. *IAQ Tools for Schools*. EPA-402-K-95-001. May 1995.

Appendix A – Glossary

- Allergen.....Substance (such as mold) that can cause an allergic reaction.
- APR.....Air purifying respirator
- BiocideSubstance or chemical that kills organisms such as molds.
- EPAEnvironmental Protection Agency
- FungiFungi are neither animals nor plants and are classified in a kingdom of their own. Fungi include molds, yeasts, mushrooms, and puffballs. In this document, the terms fungi and mold are used interchangeably. Molds reproduce by making spores. Mold spores waft through the indoor and outdoor air continually. When mold spores land on a damp spot indoors, they may begin growing and digesting whatever they are growing on. Molds can grow on virtually any organic substance, providing moisture and oxygen are present. It is estimated that more than 1.5 million species of fungi exist.
- Fungicide.....Substance or chemical that kills fungi.
- HEPAHigh-Efficiency Particulate Air
- HypersensitivityGreat or excessive sensitivity
- IAQIndoor Air Quality
- Mold.....Molds are a group of organisms that belong to the kingdom Fungi. In this document, the terms fungi and mold are used interchangeably. There are over 20,000 species of mold.

- mVOC.....Microbial volatile organic compound, a chemical made by a mold which may have a moldy or musty odor.
- OSHA.....Occupational Safety and Health Administration
- PAPR.....Powered air purifying respirator
- PPE.....Personal Protective Equipment
- RemediateFix
- Sensitization.....Repeated or single exposure to an allergen that results in the exposed individual becoming hypersensitive to the allergen.
- SporeMolds reproduce by means of spores. Spores are microscopic; they vary in shape and size (2 – 100 micrometers). Spores may travel in several ways—they may be passively moved (by a breeze or waterdrop), mechanically disturbed (by a person or animal passing by), or actively discharged by the mold (usually under moist conditions or high humidity).

Appendix B – Introduction to Molds

Molds in the Environment

Molds live in the soil, on plants, and on dead or decaying matter. Outdoors, molds play a key role in the breakdown of leaves, wood, and other plant debris. Molds belong to the kingdom Fungi, and unlike plants, they lack chlorophyll and must survive by digesting plant materials, using plant and other organic materials for food. Without molds, our environment would be overwhelmed with large amounts of dead plant matter.

Molds produce tiny spores to reproduce, just as some plants produce seeds. These mold spores can be found in both indoor and outdoor air, and settled on indoor and outdoor surfaces. When mold spores land on a damp spot, they may begin growing and digesting whatever they are growing on in order to survive. Since molds gradually destroy the things they grow on, you can prevent damage to building materials and furnishings and save money by eliminating mold growth.

Moisture control is the key to mold control. Molds need both food and water to survive; since molds can digest most things, water is the factor that limits mold growth. Molds will often grow in damp or wet areas indoors. Common sites for indoor mold growth include bathroom tile, basement walls, areas around windows where moisture condenses, and near leaky water fountains or sinks. Common sources or causes of water or moisture problems include roof leaks, deferred maintenance, condensation associated with high humidity or cold spots in the building, localized flooding due to plumbing failures or heavy rains, slow leaks in plumbing fixtures, and malfunction or poor design of humidification systems. Uncontrolled humidity can also be a source of moisture leading to mold growth, particularly in hot, humid climates.

Health Effects and Symptoms Associated with Mold Exposure

When moisture problems occur and mold growth results, building occupants may begin to report odors and a variety of health problems, such as headaches, breathing difficulties, skin irritation, allergic reactions, and aggravation of asthma symptoms; all of these symptoms could potentially be associated with mold exposure.

All molds have the potential to cause health effects. Molds produce allergens, irritants, and in some cases, toxins that may cause reactions in humans. The types and severity of symptoms depend, in part, on the types of mold present, the extent of an individual's exposure, the ages of the individuals, and their existing sensitivities or allergies. Specific reactions to mold growth can include the following:

Allergic Reactions: Inhaling or touching mold or mold spores may cause allergic reactions in sensitive individuals. Allergic reactions to mold are common—these reactions can be immediate or delayed. Allergic responses include hay fever-type symptoms, such as sneezing, runny nose, red eyes, and skin rash (dermatitis). Mold spores and fragments can produce allergic reactions in sensitive individuals regardless of whether the mold is dead or alive. Repeated or single exposure to mold or mold spores may cause previously non-sensitive individuals to become sensitive. Repeated exposure has the potential to increase sensitivity.

Asthma: Molds can trigger asthma attacks in persons who are allergic (sensitized) to molds. The irritants produced by molds may also worsen asthma in non-allergic (non-sensitized) people.

Hypersensitivity Pneumonitis: Hypersensitivity pneumonitis may develop following either short-term (acute) or long-term (chronic) exposure to molds. The disease resembles bacterial pneumonia and is uncommon.

Potential Health Effects Associated with Inhalation Exposure to Molds and Mycotoxins

- Allergic Reactions (e.g., rhinitis and dermatitis or skin rash)
 - Asthma
 - Hypersensitivity Pneumonitis
 - Other Immunologic Effects
- Research on mold and health effects is ongoing. This list is not intended to be all-inclusive.

The health effects listed above are well documented in humans. Evidence for other health effects in humans is less substantial and is primarily based on case reports or occupational studies.

Irritant Effects: Mold exposure can cause irritation of the eyes, skin, nose, throat, and lungs, and sometimes can create a burning sensation in these areas.

Opportunistic Infections: People with weakened immune systems (i.e., immune-compromised or immune-suppressed individuals) may be more vulnerable to infections by molds (as well as more vulnerable than healthy persons to mold toxins). *Aspergillus fumigatus*, for example, has been known to infect the lungs of immune-compromised individuals. These individuals inhale the mold spores which then start growing in their lungs. *Trichoderma* has also been known to infect immune-compromised children.

Healthy individuals are usually not vulnerable to opportunistic infections from airborne mold exposure. However, molds can cause common skin diseases, such as athlete's foot, as well as other infections such as yeast infections.

Mold Toxins (Mycotoxins)

Molds can produce toxic substances called mycotoxins. Some mycotoxins cling to the surface of mold spores; others may be found within spores. More than 200 mycotoxins have been identified from common molds, and many more remain to be identified. Some of the molds that are known to produce mycotoxins are commonly found in moisture-damaged buildings. Exposure pathways for mycotoxins can include inhalation, ingestion, or skin contact. Although some mycotoxins are well known to affect humans and have been shown to be responsible for human health effects, for many mycotoxins, little information is available.

Aflatoxin B₁ is perhaps the most well known and studied mycotoxin. It can be produced by the molds *Aspergillus flavus* and *Aspergillus parasiticus* and is one of the most potent carcinogens known. Ingestion of aflatoxin B₁ can cause liver cancer. There is also some evidence that inhalation of aflatoxin B₁ can cause lung cancer. Aflatoxin B₁ has been found on contaminated grains, peanuts, and other human and animal foodstuffs. However, *Aspergillus flavus* and *Aspergillus parasiticus* are *not* commonly found on building materials or in indoor environments.

Much of the information on the human health effects of inhalation exposure to mycotoxins comes from studies done in the workplace and some case studies or case reports.* Many symptoms and human health effects attributed to inhalation of mycotoxins have been reported including: mucous membrane irritation, skin rash, nausea, immune system suppression, acute or chronic liver damage, acute or chronic central nervous system damage, endocrine effects, and cancer. More studies are needed to get a clear picture of the health effects related to most mycotoxins. However, it is clearly prudent to avoid exposure to molds and mycotoxins.

Some molds can produce several toxins, and some molds produce mycotoxins only under certain environmental conditions. The presence of mold in a building does not necessarily mean that mycotoxins are present or that they are present in large quantities.

Toxic Molds

Some molds, such as *Aspergillus versicolor* and *Stachybotrys atra* (*chartarum*), are known to produce potent toxins under certain circumstances. Although some mycotoxins are well known to affect humans and have been shown to be responsible for human health effects, for many mycotoxins, little information is available, and in some cases research is ongoing. For example, some strains of *Stachybotrys atra* can produce one or more potent toxins. In addition, preliminary reports from an investigation of an outbreak of pulmonary hemorrhage in infants suggested an association between pulmonary hemorrhage and exposure to *Stachybotrys chartarum*. Review of the evidence of this association at the Centers for Disease Control and Prevention (CDC) resulted in a published clarification stating that such an association was not established. Research on the possible causes of pulmonary hemorrhage in infants continues. Consult CDC for more information on pulmonary hemorrhage in infants (see Resources List, page 31, for CDC contact and other information).

* Information on ingestion exposure, for both humans and animals, is more abundant—a wide range of health effects has been reported following ingestion of moldy foods including liver damage, nervous system damage and immunological effects.

Microbial Volatile Organic Compounds (mVOCs)

Some compounds produced by molds are volatile and are released directly into the air. These are known as microbial volatile organic compounds (mVOCs). Because these compounds often have strong and/or unpleasant odors, they can be the source of odors associated with molds. Exposure to mVOCs from molds has been linked to symptoms such as headaches, nasal irritation, dizziness, fatigue, and nausea. Research on mVOCs is still in the early phase.

Glucans or Fungal Cell Wall Components (also known as β -(1,3)-D-Glucans)

Glucans are small pieces of the cell walls of molds which may cause inflammatory lung and airway reactions. These glucans can affect the immune system when inhaled. Exposure to very high levels of glucans or dust mixtures including glucans may cause a flu-like illness known as Organic Dust Toxic Syndrome (ODTS). This illness has been primarily noted in agricultural and manufacturing settings.

Spores

Mold spores are microscopic (2 – 10 μ m) and are naturally present in both indoor and outdoor air. Molds reproduce by means of spores. Some molds have spores that are easily disturbed and waft into the air and settle repeatedly with each disturbance. Other molds have sticky spores that will cling to surfaces and are dislodged by brushing against them or by other direct contact. Spores may remain able to grow for years after they are produced. In addition, whether or not the spores are alive, the allergens in and on them may remain allergenic for years.

Appendix C – Communication With Building Occupants

Communication with building occupants is essential for successful mold remediation. Some occupants will naturally be concerned about mold growth in their building and the potential health impacts. Occupants' perceptions of the health risk may rise if they perceive that information is being withheld from them. The status of the building investigation and remediation should be openly communicated including information on any known or suspected health risks.

Small remediation efforts will usually not require a formal communication process, but do be sure to

take individual concerns seriously and use common sense when deciding whether formal communications are required. Individuals managing medium or large remediation efforts should make sure they understand and address the concerns of building occupants and communicate clearly what has to be done as well as possible health concerns.

Communication approaches include regular memos and/or meetings with occupants (with time allotted for questions and answers), depending on the scope of the remediation and the level of occupant interest. Tell the occupants about the size of the project, planned activities, and remediation timetable. Send or post regular updates on the remediation progress, and send or post a final memo when the project is completed or hold a final meeting. Try and resolve

Mold in Schools

Special communication strategies may be desirable if you are treating a mold problem in a school. Teachers, parents, and other locally affected groups should be notified of significant issues as soon as they are identified. Consider holding a special meeting to provide parents with an opportunity to learn about the problem and ask questions of school authorities, particularly if it is necessary/advisable to ensure that the school is vacated during remediation. For more information on investigating and remediating molds in schools, refer to the U.S. EPA's *IAQ Tools for Schools* kit and the asthma companion piece for the *IAQ Tools for Schools* kit, entitled *Managing Asthma in the School Environment*.

Communicate, When You Remediate

- Establish that the health and safety of building occupants are top priorities.
- Demonstrate that the occupants' concerns are understood and taken seriously.
- Present clearly the current status of the investigation or remediation efforts.
- Identify a person whom building occupants can contact directly to discuss questions and comments about the remediation activities.

issues and occupant concerns as they come up. When building-wide communications are frequent and open, those managing the remediation can direct more time toward resolving the problem and less time to responding to occupant concerns.

If possible, remediation activities should be scheduled during off-hours when building occupants are less likely to be affected. Communication is important if occupants are relocated during remediation. The decision to relocate occupants should consider the size of the area affected, the extent and types of health effects exhibited by the occupants, and the potential health risks associated with debris and activities during the remediation project. When considering the issue of relocation, be sure to inquire about, accommodate, and plan for

individuals with asthma, allergies, compromised immune systems, and other health-related concerns. Smooth the relocation process and give occupants an opportunity to participate in resolution of the problem by clearly explaining the disruption of the workplace and work schedules. Notify individuals of relocation efforts in advance, if possible.

INDEX

| | |
|--|---------------------------------------|
| Biocides | 18 |
| Bleach | 18, 20 |
| Cleanup methods | 11, 14, 15, 16-19, 22, 23, 27 |
| Containment | 14, 15, 18, 21-23, 27 |
| Duct cleaning | 7, 12 |
| Health effects | 1, 2, 12, 39-43, 46 |
| HEPA vacuum | 15, 17, 23 |
| Hidden mold | 4, 8, 27 |
| HVAC system | 3, 7, 9, 22, 24 |
| Moisture meters | 23, 24 |
| Mold toxins/mycotoxins | 2, 13, 17, 19, 40-42 |
| Paint | 17 |
| Personal Protective Equipment (PPE) | 4, 6, 8, 9, 11, 14, 15, 17-21, 23, 27 |
| Regulations | 12, 33 |
| Respiratory protection | 14, 15, 19, 20, 23 |
| Sampling | 25, 26 |
| Schools | 1, 29, 45 |
| Standards | 12, 25 |

NOTES

This is a reprint of EPA document 402-K-01-001, March 2001. The guidance has not changed. The Resources List has been updated.